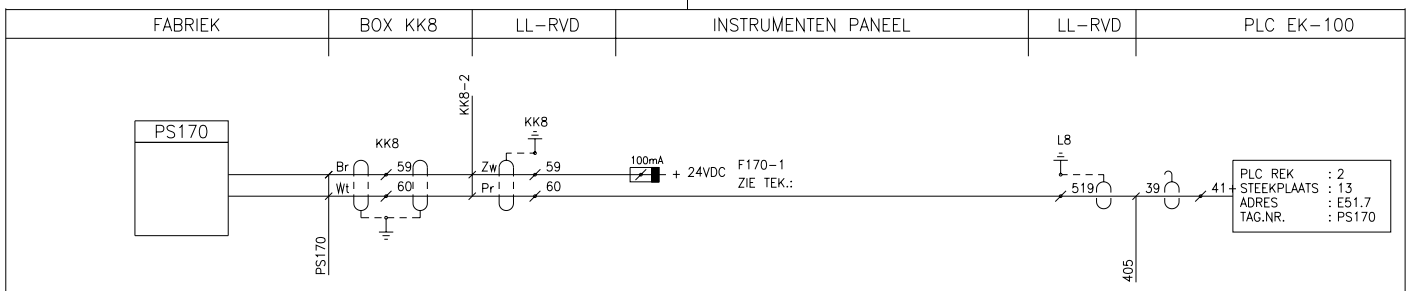

						A	13-09-1994	FOR APPROVAL	M.V.	J.S	J.Li	
						B	14-09-1994	AS BUILT	P.G	J.S.	J.Li.	
						Rev.:	Date:	Disription:	Drawn by:	Ckd:	Seen by:	
						HVL ELEKTROTECHNIEK POSTBUS 1341 6201 BH MAASTRICHT 043-619090		Client: LB METREX B.V.				
								Project: WARME STRAAT				
								Title: HOOK-UP PS SPOELLUCHT DOEKENFILTER F-150				Tag number: P-170
PS170	SATCHWELL UH 2206			0,6-6,0 BAR		Drawn by: P.G.15-12-1994	Filenumber: P-170	Scale: - : -	Size: A4	Ordernumber: 9580	Sub.: 00	Drawing number: 3-H-100
TAG Nr.:	Fabrikaat en Type:	Spec./Magn.Nr	Instelling	Meetbereik	Opm./Tek.							Sht.: 0000 of: 0000 Rev. B

0 10 20 30 40 50 60 70 80 90 100 mm

Demo Version