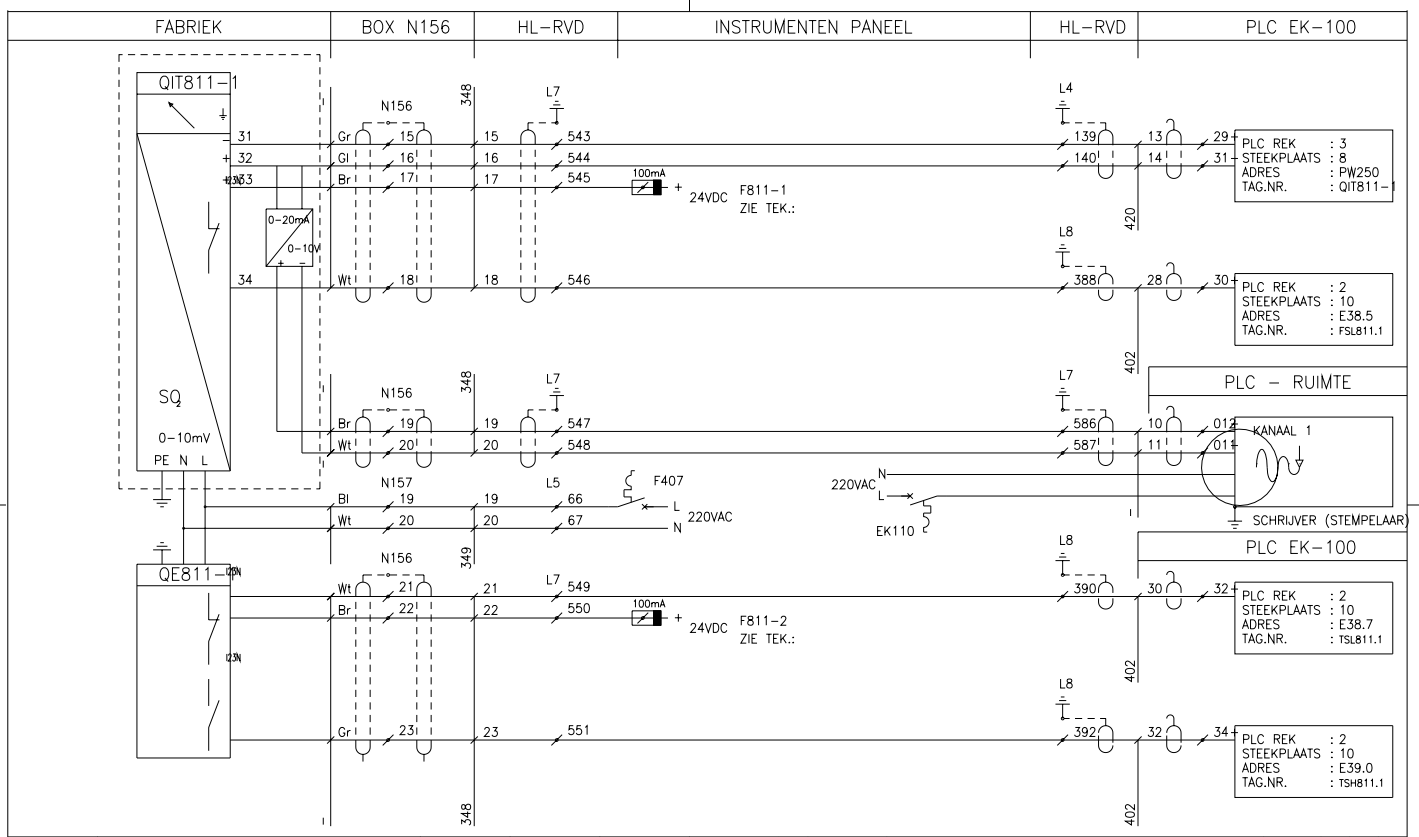

						A	26-10-1994	SEVERAL CHANGES			R.G.	J.S.	J.Li.	
						B	14-12-1994	AS BUILT			N.S.	J.S.	J.Li.	
						Rev.:	Date:	Disription:			Drawn by:	Ckd:	Seen by:	
						HVL ELEKTROTECHNIEK POSTBUS 1341 6201 BH MAASTRICHT 043-619090		Client: LB METREX B.V.						
								Project: ROOKGAS ONTZWAVELING						
								Title: HOOK-UP SO_2 IN GEWASSEN ROOKGASSEN NAAR STACK					Tag number: Q-811	
QE811-1	SONDE / OPNEMER					Drawn by: R.G. 18-08-1994		Filenumber: Q-811	Scale: - : -	Size: A3	Ordernumber: 9580	Sub.: 00	Drawing number: 3-H-800	Sht.: 0000 of: 0000 Rev. B
QIT811-1	ADC GAS ANALYSER													
TAG Nr.:	Fabrikaat en Type:	Spec./Magn.Nr	Instelling	Meetbereik	Opm./Tek.									

Demo Version