


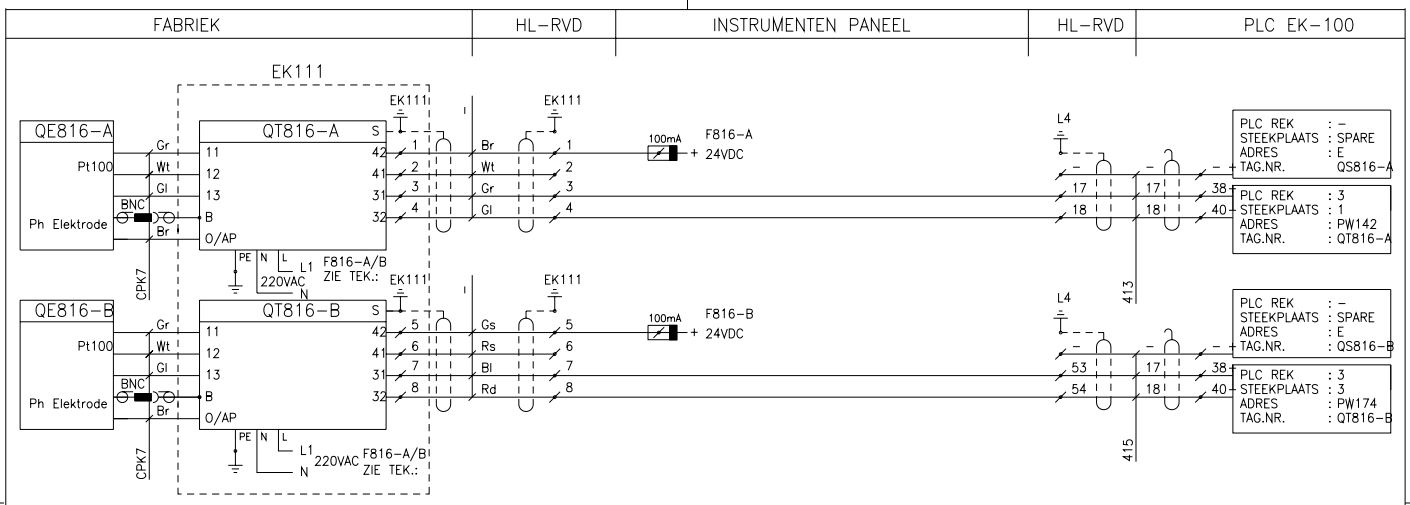


| Rev.: | Date: | Disription: | Drawn by: | Ckd: | Seen by: |
|---|---|---|---|---|---|
| A | 26-10-1994 | SEVERAL CHANGES | R.G. | J.S. | J.Li. |
| B | 14-12-1994 | AS BUILT | N.S. | J.S. | J.Li. |

| TAG Nr.: | Fabrikaat en Type: | Spec./Magn.Nr | Instelling | Meetbereik | Opm./Tek. |
|---|---|---|---|---|---|
| QCV816 | +GF+ 021 | | | | |
| QT816B | E&H CPM 121 - P11A00 | | | | |
| QE816B | E&H CPA 250-A | | | | |
| QT816A | E&H CPM 121 - P11A00 | | | | |
| QE816A | E&H CPA 250-A | | | | |

HVL ELEKTROTECHNIEK
POSTBUS 1341
6201 BH MAASTRICHT
043-619090

Client: LB METREX B.V.
Project: ROOKGAS ONTZWAVELING
Title: HOOK-UP Ph AFVOER KOLOM C816
Tag number: Q-816
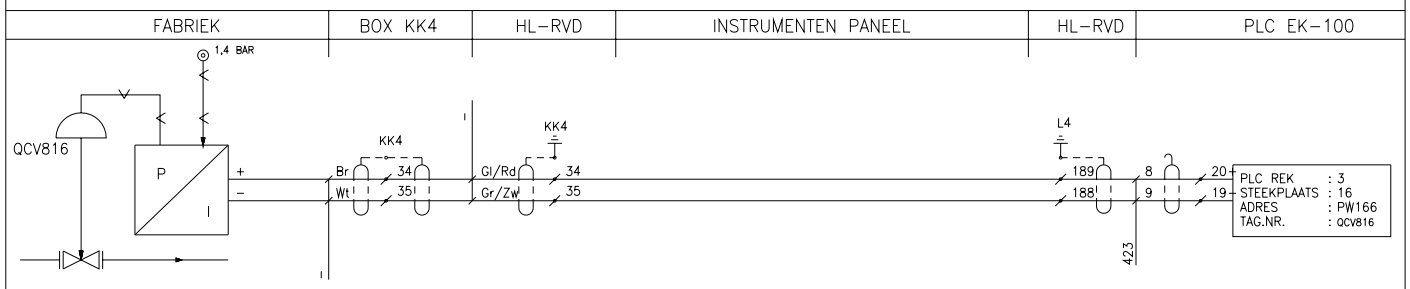
| Drawn by: | Filenumber: | Scale: | Size: | Ordernumber: | Sub.: | Drawing number: | Sht.: | of: | Rev. |
|---|---|---|---|---|---|---|---|---|---|
| R.G. 18-08-1994 | Q-816 | - : - | A3 | 9580 | 00 | 3-H-800 | 0000 | 0000 | B |

0 10 20 30 40 50 60 70 80 90 100 mm

Demo Version