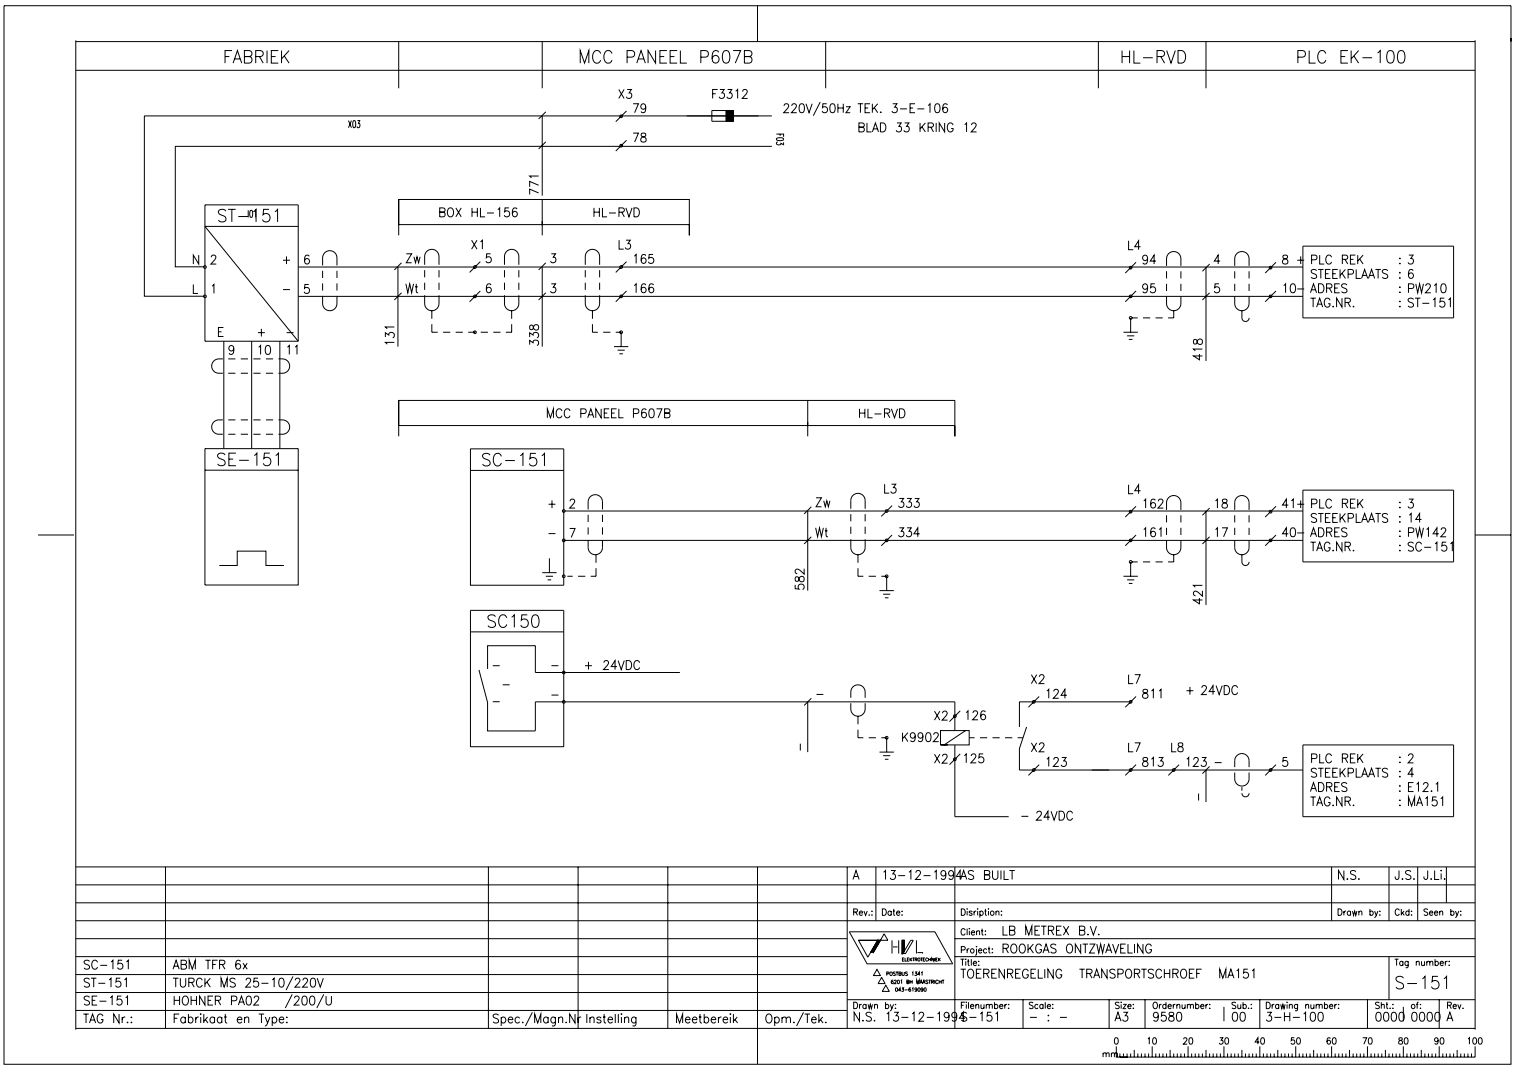

SC-151	ABM TFR 6x				
ST-151	TURCK MS 25-10/220V				
SE-151	HOHNER PA02 /200/U				
TAG Nr.:	Fabrikaat en Type:	Spec./Magn.Nr	Instelling	Meetbereik	Opm./Tek.

Rev.:	Date:	Disription:	Drawn by:	Ckd:	Seen by:
A	13-12-1994	AS BUILT	N.S.	J.S.	J.Li.

HVL ELEKTROTECHNIEK
POSTBUS 1341
6201 BH MAASTRICHT
043-619090

Client: LB METREX B.V.
Project: ROOKGAS ONTZWAVELING
Title: TOERENREGELING TRANSPORTSCHROEF MA151
Tag number: S-151

Drawn by:	Filenumber:	Scale:	Size:	Ordernumber:	Sub.:	Drawing number:	Sht.: of:	Rev.
N.S. 13-12-1994	S-151	- : -	A3	9580	00	3-H-100	0000 0000	A

mm 0 10 20 30 40 50 60 70 80 90 100

Demo Version