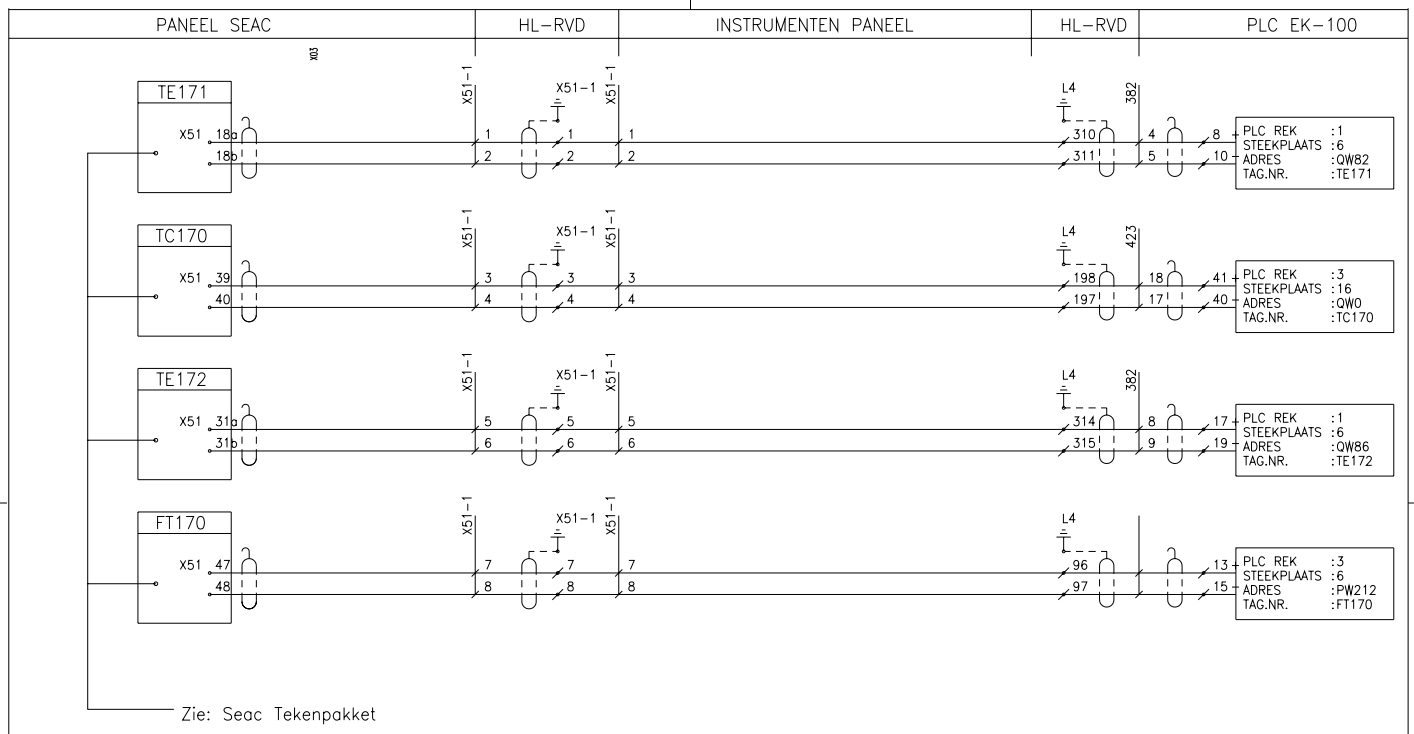

TAG Nr.:	Fabrikaat en Type:	Spec./Magn.Nr	Instelling	Meetbereik	Opm./Tek.
FT170	WATERFLOW TO RECORDER				
TE172	T-UITLAAT ALARMEENHEID				
TC170	Y-REGELAAR STELGROOTTE				
TE171	T-INLAATSIGNAAL				

Rev.:	Date:	Dispiption:	Drawn by:	Ckd:	Seen by:
A	07-11-1994	SEVERAL CHANGES	R.G.	J.S.	J.Li.
B	16-12-1994	AS BUILT	P.G.	J.S.	J.Li.

HVL ELEKTROTECHNIEK
POSTBUS 1341
6201 BH MAASTRICHT
043-619090

Client: LB METREX B.V.
Project: WARME STRAAT
Title: HOOK-UP SEAC INTERFACE
Tag number: SEAC11

Drawn by:	Filenumber:	Scale:	Size:	Ordernumber:	Sub.:	Drawing number:	Sht.:	of:	Rev.
M.V. 13-09-1994	SEAC11	- : -	A4	9580	00	3-H-100	0000	0000	B

Demo Version