PANEEL SEAC	HL-RVD	INSTRUMENTEN PANEEL	HL-RVD	PLC EK-100

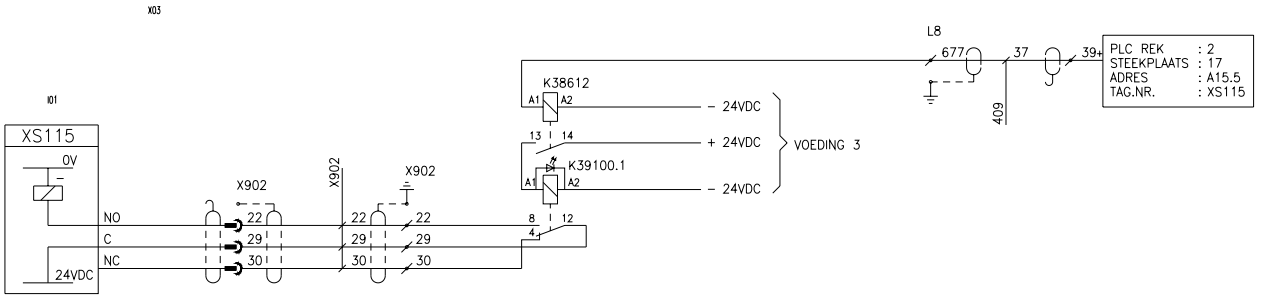

VOOR X902: Zie Tek. 470.X902 "SEAC PAKKET"

						A	07-11-1994	SEVERAL CHANGES		R.G.	J.S.	J.Li.		
						B	16-12-1994	AS BUILT		P.G.	J.S.	J.Li.		
						Rev.:	Date:	Disription:		Drawn by:	Ckd:	Seen by:		
						HVL ELEKTROTECHNIEK POSTBUS 1341 6201 BH MAASTRICHT 043-619090		Client: LB METREX B.V.						
								Project: WARME STRAAT						
								Title: HOOK-UP SEAC INTERFACE X902 BLAD. 3					Tag number: SEAC3	
XS115	START					Drawn by: M.V. 13-09-1994		Filenumber: SEAC9023	Scale: - : -	Size: A4	Ordernumber: 9580	Sub.: 00	Drawing number: 3-H-100	Sht.: 0000 of: 0000 Rev. B
TAG Nr.:	Fabrikaat en Type:	Spec./Magn.Nr	Instelling	Meetbereik	Opm./Tek.									

0 10 20 30 40 50 60 70 80 90 100 mm

Demo Version