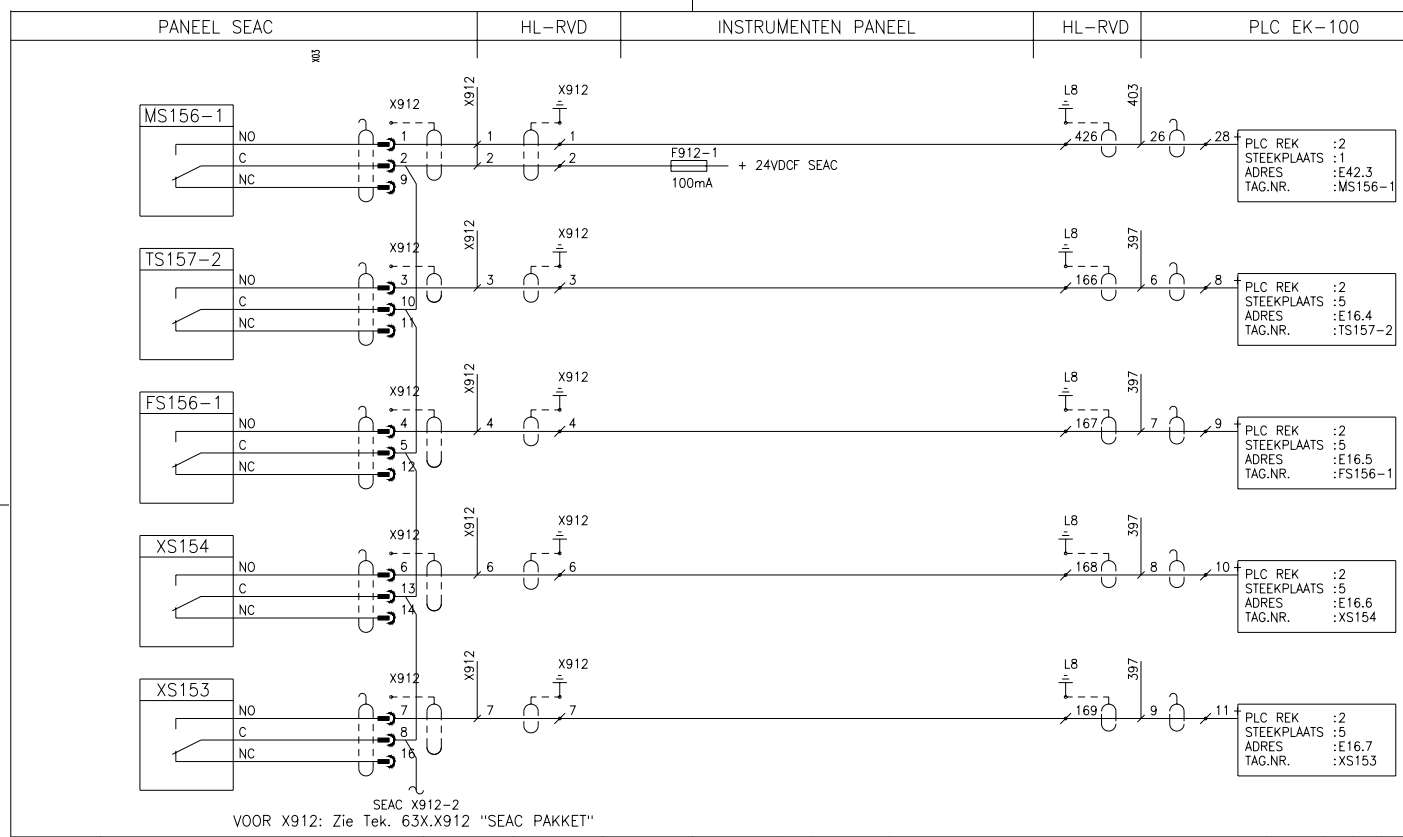

TAG Nr.:	Fabrikaat en Type:	Spec./Magn.Nr	Instelling	Meetbereik	Opm./Tek.
XS153	POMP 2 DRAAIT, GEEN STROMING				
XS154	POMP 1 DRAAIT, GEEN STROMING				
FS156-1	POMP 1 STROOMT DOOR				
TS157-2	POMP 1 THERMISCHE STORING				
MS156-1	POMP 1 LOOPT				

Rev.:	Date:	Disription:	Drawn by:	Ckd:	Seen by:
A	18-10-1994	SEVERAL CHANGES	R.G.	J.S.	J.Li.
B	16-12-194	AS BUILT	P.G.	J.S.	J.Li.

HVL ELEKTROTECHNIEK
POSTBUS 1341
6201 BH MAASTRICHT
043-610060

Client: LB METREX B.V.
Project: WARME STRAAT
Title: HOOK-UP
SEAC INTERFACE X912 BLAD. 1
Tag number: SEAC4

Drawn by:	Filenumber:	Scale:	Size:	Ordernumber:	Sub.:	Drawing number:	Sht.:	of:	Rev.
M.V. 13-09-1994	SEAC9121	- : -	A4	9580	00	3-H-100	0000	0000	B

0 10 20 30 40 50 60 70 80 90 100 mm

Demo Version