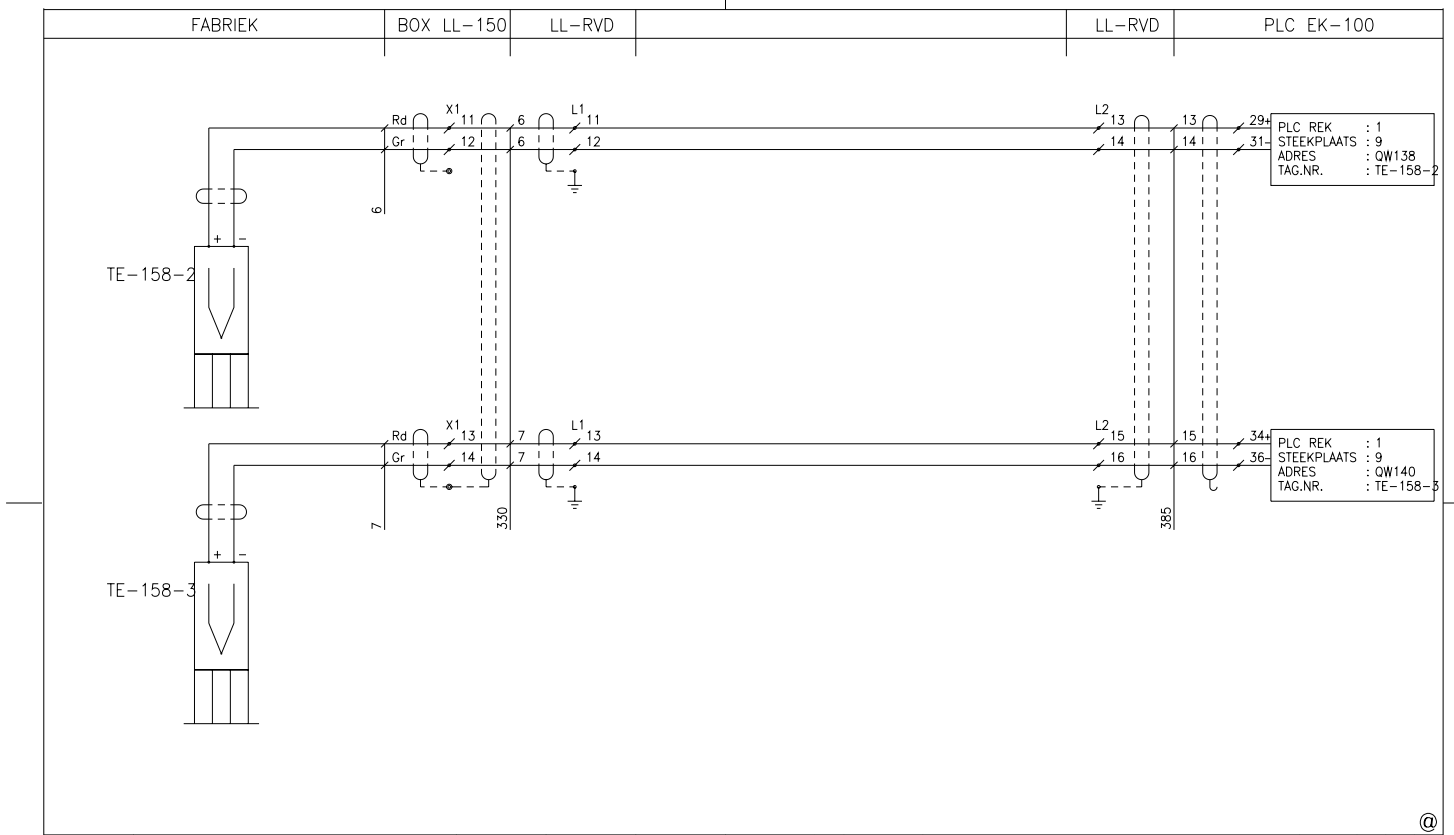

TE-158-3	SENSYCON TM110F 0-50mV	67			
TE-158-2	SENSYCON TM110F 0-50mV	67			
TAG Nr.:	Fabrikaat en Type:	Spec./Magn.Nr	Instelling	Meetbereik	Opm./Tek.

Rev.:	Date:	Disription:	Drawn by:	Ckd:	Seen by:
A	15-12-1994	AS BUILT	R.B.	J.S.	J.Li.
0	15-07-1994	FOR APPROVAL	R.G.	J.S.	J.Li.

HVL ELEKTROTECHNIEK
POSTBUS 1341
6201 BH MAASTRICHT
043-619090

Client: LB METREX B.V.
Project: WARME STRAAT
Title: HOOK-UP TEMPERATUUR BED 1
Tag number: T158-1

Drawn by:	Filenumber:	Scale:	Size:	Ordernumber:	Sub.:	Drawing number:	Sht.:	of:	Rev.
R.G. 05-07-1994	4158-1	- : -	A3	9580	00	T158-1	0000	0000	A

mm 0 10 20 30 40 50 60 70 80 90 100

Demo Version