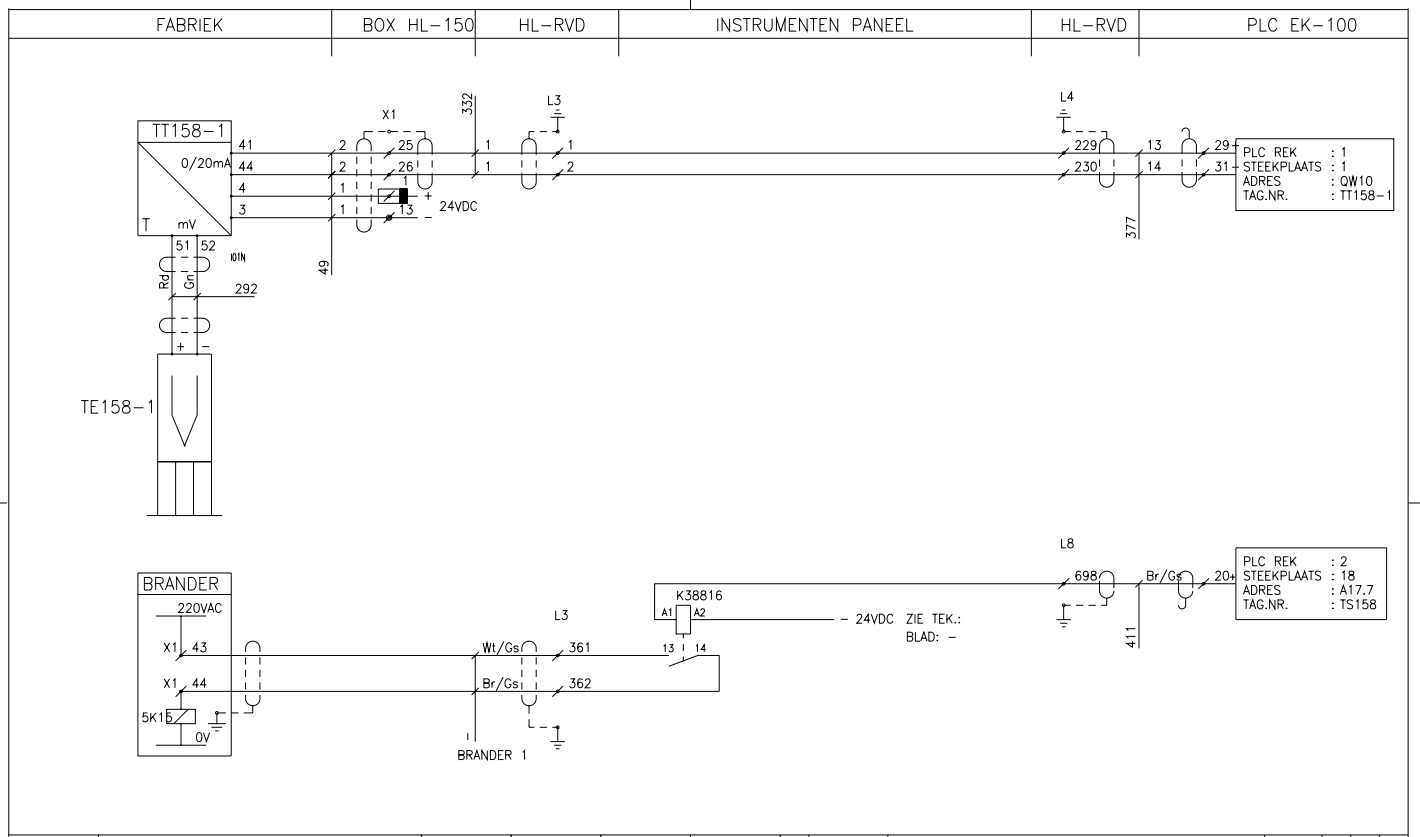

5K15	TEMPERATUUR BED 1 < 1000°C				
TT158-1	H&B TEU (11331-0-8151005)	123		0-1200°C	
TE158-1	SENSYCON TM110F	67			
TAG Nr.:	Fabrikaat en Type:	Spec./Magn.Nr	Instelling	Meetbereik	Opm./Tek.

Rev.:	Date:	Disription:	Drawn by:	Ckd:	Seen by:
A	15-12-1994	AS BUILT	R.B.	J.S.	J.Li.
0	07-09-1994	FOR APPROVAL	M.V.	J.S.	J.Li.

HVL ELEKTROTECHNIEK
POSTBUS 1341
6201 BH MAASTRICHT
043-619090

Client: LB METREX B.V.
Project: WARME STRAAT
Title: HOOK-UP TEMPERATUUR BED 1
Tag number: T158-2

Drawn by:	Filenumber:	Scale:	Size:	Ordernumber:	Sub.:	Drawing number:	Sht.:	of:	Rev.
M.V. 07-09-1994	4158-2	- : -	A3	9580	00	3-H-100	0000	0000	A

0 10 20 30 40 50 60 70 80 90 100 mm

Demo Version