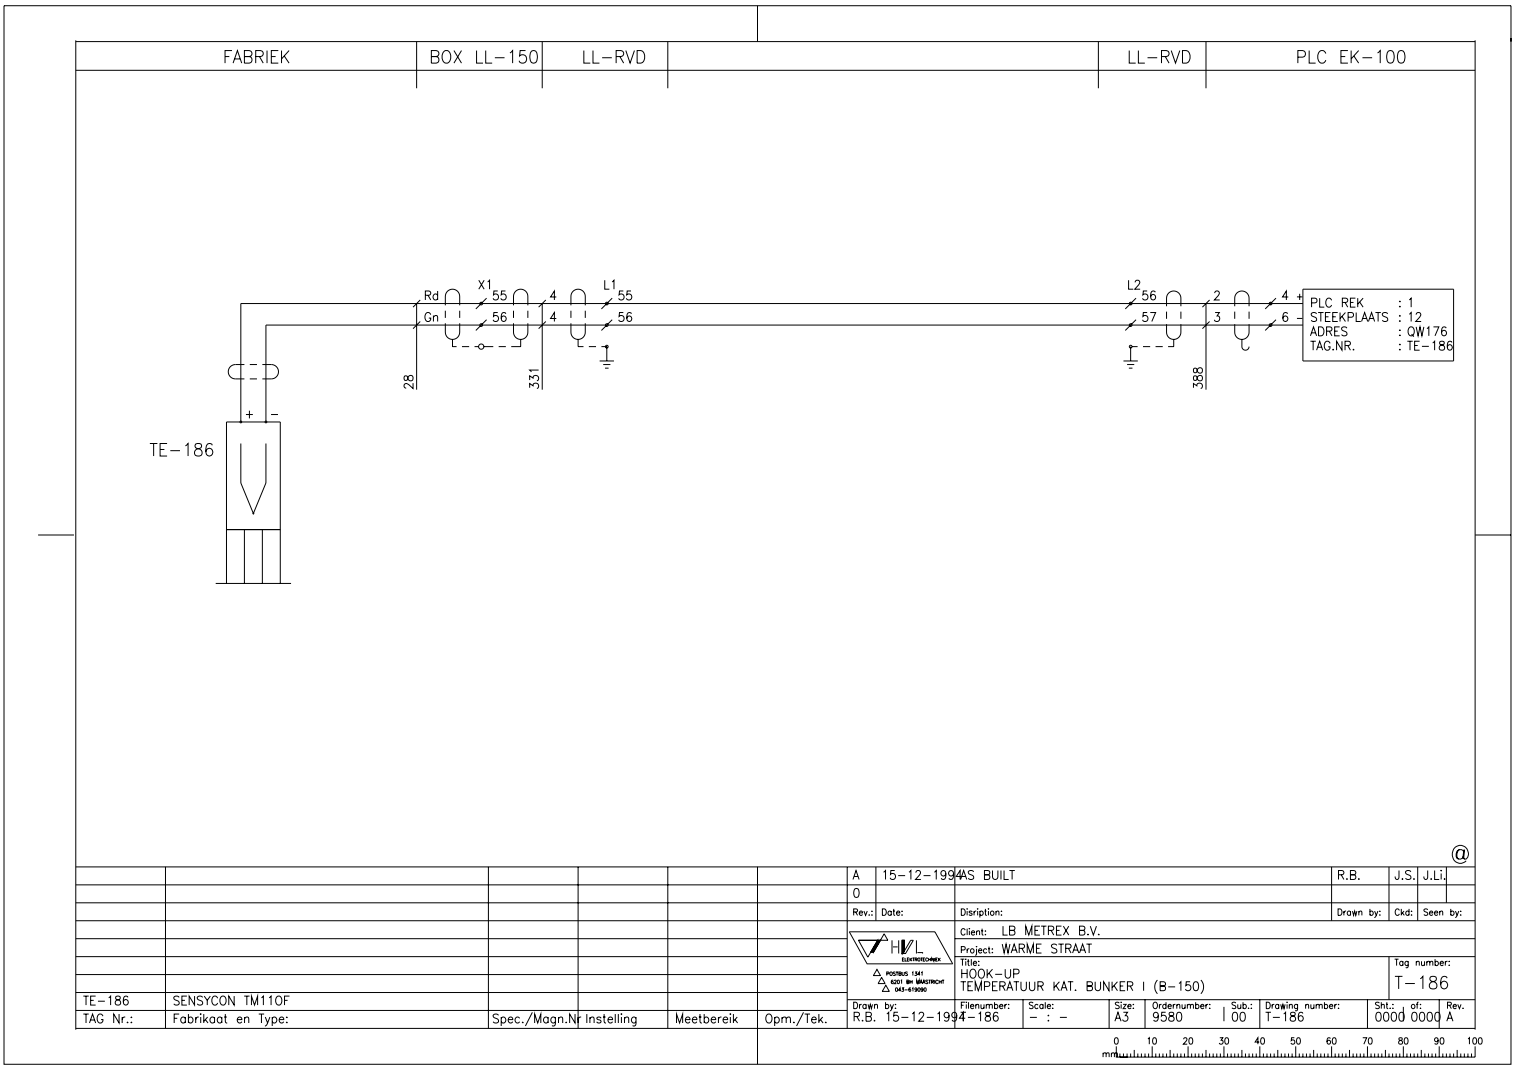

						A	15-12-1994	AS BUILT		R.B.	J.S.	J.Li.	
						0							
						Rev.:	Date:	Disription:		Drawn by:	Ckd:	Seen by:	
TE-186	SENSYCON TM110F					Client: LB METREX B.V.							
TAG Nr.:	Fabrikaat en Type:	Spec./Magn.Nr	Instelling	Meetbereik	Opm./Tek.	Project: WARME STRAAT							
						Title: HOOK-UP TEMPERATUUR KAT. BUNKER I (B-150)						Tag number: T-186	
						Drawn by: R.B. 15-12-1994	Filenumber: T-186	Scale: - : -	Size: A3	Ordernumber: 9580	Sub.: 00	Drawing number: T-186	Sht.: 0000 of: 0000 Rev. A

Demo Version