FABRIEK	BOX KK6	HL-RVD	INSTRUMENTEN PANEEL	HL-RVD	PLC EK-100

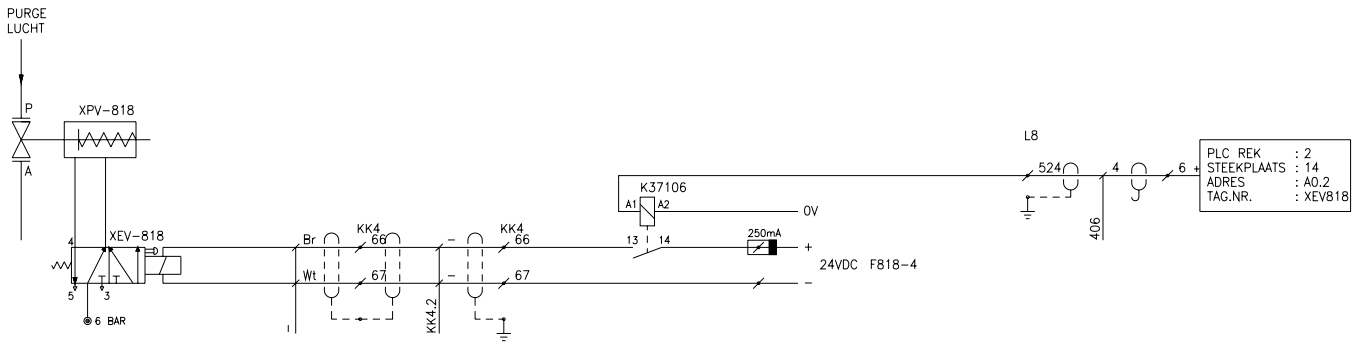

Rev.:	Date:	Disription:	Drawn by:	Ckd:	Seen by:
A	14-12-1994	AS BUILT	N.S.	J.S.	J.Li.
0	23-08-1994	FOR APPROVAL	R.G.	J.S.	J.Li.

HVL ELEKTROTECHNIEK
POSTBUS 1341
6201 BH MAASTRICHT
043-619090

Client: LB METREX B.V.
Project: ROOKGAS ONTZWAVELING
Title: HOOK-UP
PRODUCKT VAN TANK V800 NAAR TANKWAGEN
Tag number: X-818

Drawn by:	Filenumber:	Scale:	Size:	Ordernumber:	Sub.:	Drawing number:	Sht.:	of:	Rev.
R.G. 23-08-1994	X-818	- : -	A3	9580	00	3-H-800	0000	0000	A

TAG Nr.:	Fabrikaat en Type:	Spec./Magn.Nr	Instelling	Meetbereik	Opm./Tek.
XPV818	?				
XEV818	?				

mm 0 10 20 30 40 50 60 70 80 90 100

Demo Version