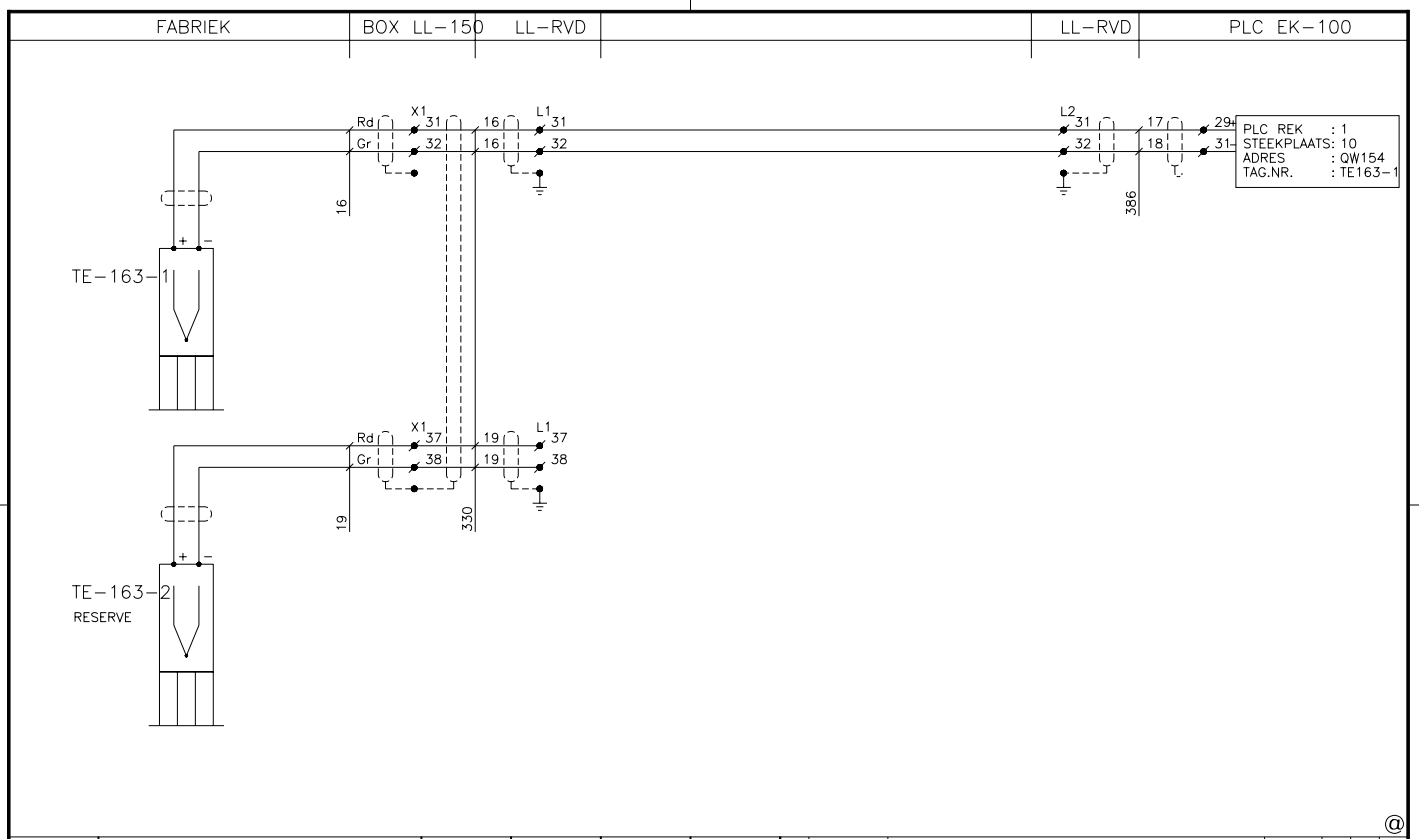

						A	15-12-1994	AS BUILT		R.B.	J.S.	J.Li
						0						
						Rev.:	Date:	Disription:		Drawn by:	Ckd:	Seen by:
TE-163-2	SENSYCON TM110F	67			RESERVE	Client: LB METREX B.V.						
TE-163-1	SENSYCON TM110F	67				Project: WARME STRAAT						
TAG Nr.:	Fabrikaat en Type:	Spec./Magn.Instelling		Meetbereik	Opm./Tek.	Title: HOOK-UP TEMPERATUUR IN FREE BOARD					Tag number: T-163	
						Drawn by: R.B. 15-12-1994	Filenumber: 94163	Scale: - : -	Size: A3	Ordernumber: 9580	Sub.: 00	Drawing number: T-163	Sht.: 00000000	of:	Rev. A

Demo Version