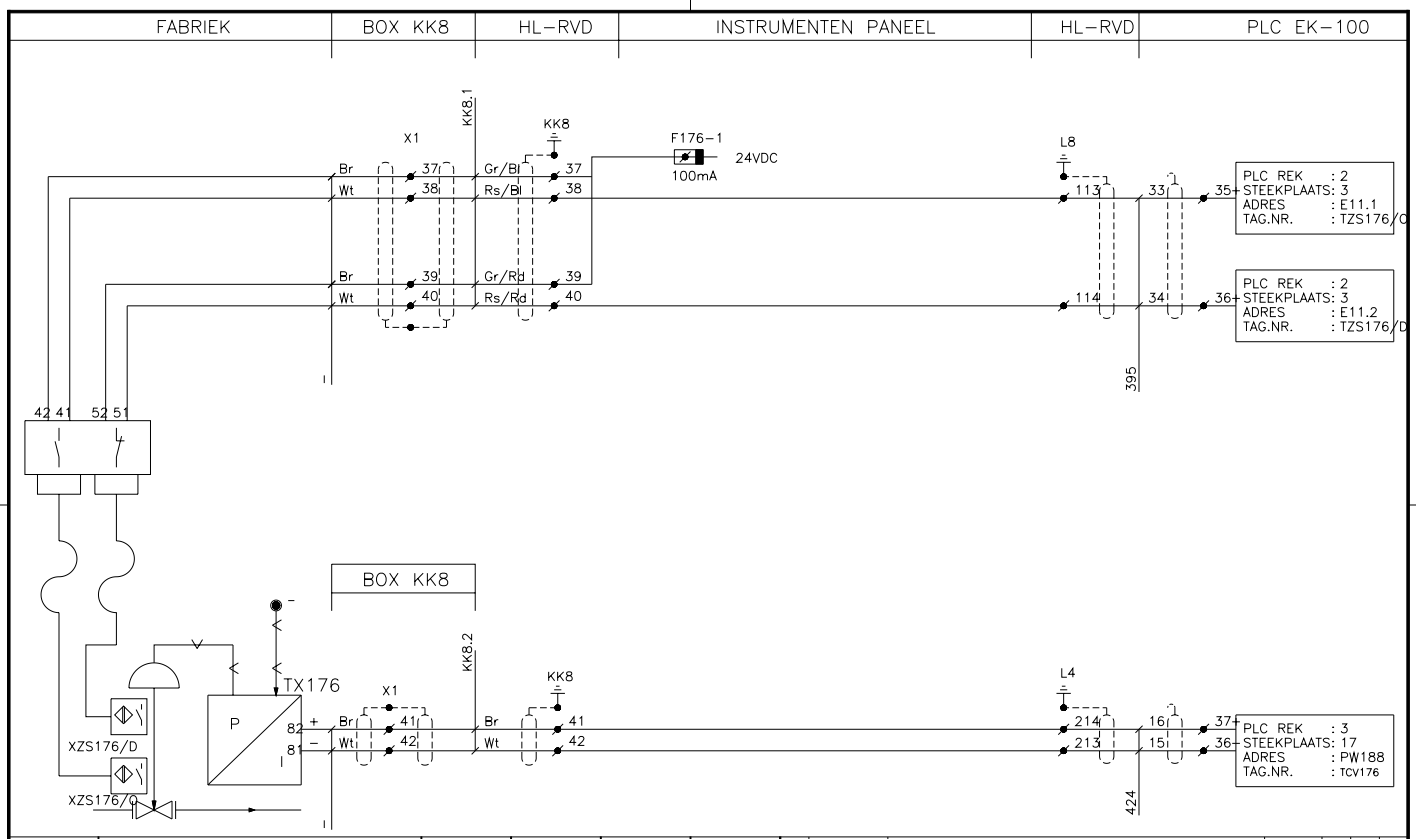

TX176	SAMSON 3767				
TCV176	SAMSON 241-1				
TAG Nr.:	Fabrikaat en Type:	Spec./Magn.	Instelling	Meetbereik	Opm./Tek.

Rev.:	Date:	Disription:	Drawn by:	Ckd:	Seen by:
A	15-12-1994	AS BUILT	R.B.	J.S.	J.Li
0	07-09-1994	FOR APPROVAL	M.V.	J.S.	J.Li

HVL ELEKTROTECHNIEK
POSTBUS 1541
6201 BH MAASTRICHT
043-6190190

Client: LB METREX B.V.
Project: WARME STRAAT
Title: HOOK-UP
TEMPERATUURREGELING MULTI CYCLOON
Tag number: T-176

Drawn by:	Filenumber:	Scale:	Size:	Ordernumber:	Sub.:	Drawing number:	Sht.:	of:	Rev.
M.V. 07-09-1994	94176	- : -	A3	9580	00	T-176	00000	00000	A

0 10 20 30 40 50 60 70 80 90 100 mm

Demo Version