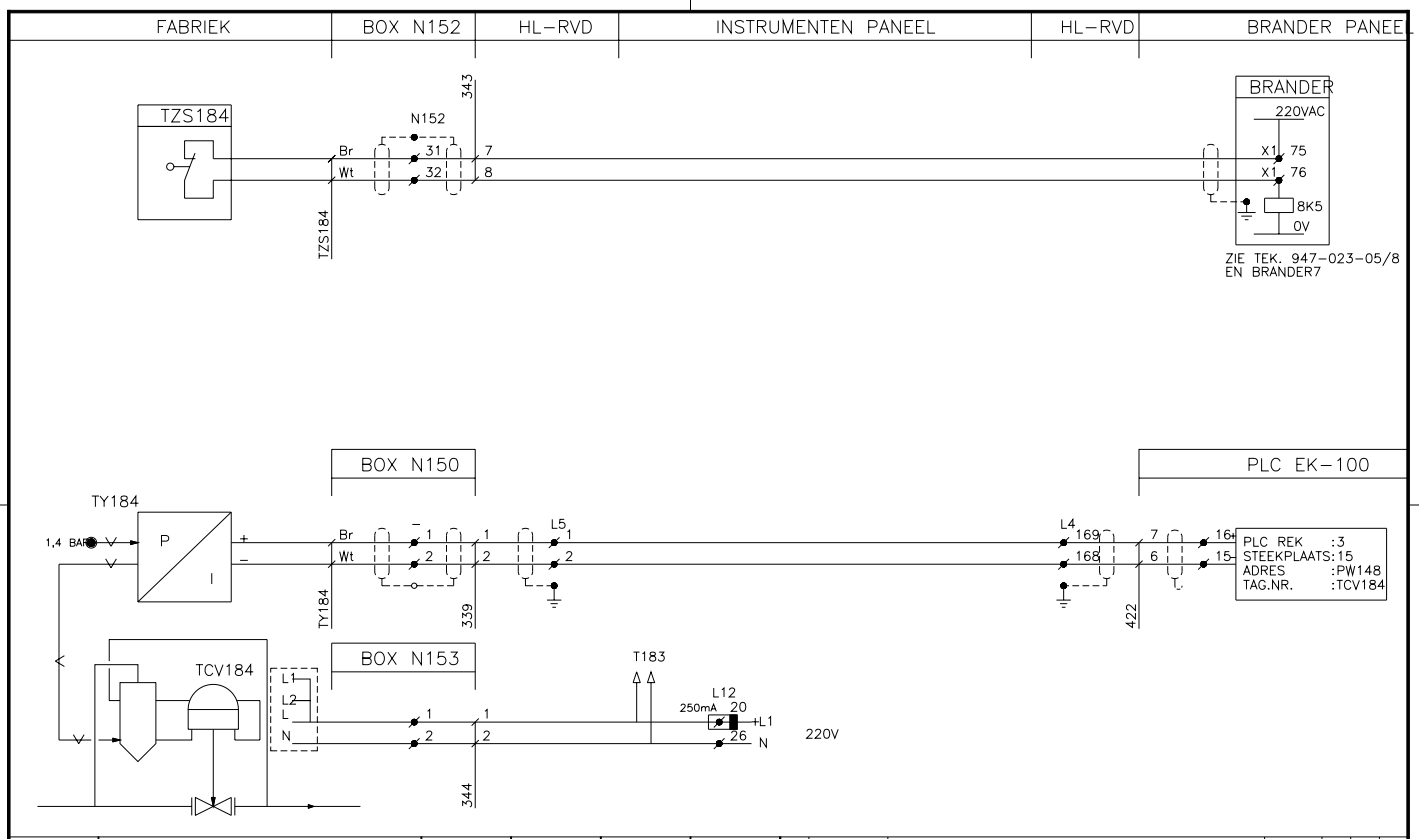

TZS184	P.U. BRANDER				
TCV184	P.U. BRANDER				
TAG Nr.:	Fabrikaat en Type:	Spec./Magn.	Nmstelling	Meetbereik	Opm./Tek.

Rev.:	Date:	Disription:	Drawn by:	Ckd:	Seen by:
A	15-12-1994	AS BUILT	R.B.	J.S.	J.Li
0	08-09-1994	FOR APPROVAL	M.V.	J.S.	J.Li

HVL ELEKTROTECHNIEK
POSTBUS 1341
6201 BH MAASTRICHT
043-6190390

Client: LB METREX B.V.
Project: WARME STRAAT
Title: HOOK-UP
GASSTRAAT HOOFDBRANDER BR-155
Tag number: T-184

Drawn by:	Filenumber:	Scale:	Size:	Ordernumber:	Sub.:	Drawing number:	Sht.:	of:	Rev.
M.V. 08-09-1994	94184	- : -	A3	9580	00	3-H-100	0000	0000	A

mm 0 10 20 30 40 50 60 70 80 90 100

Demo Version