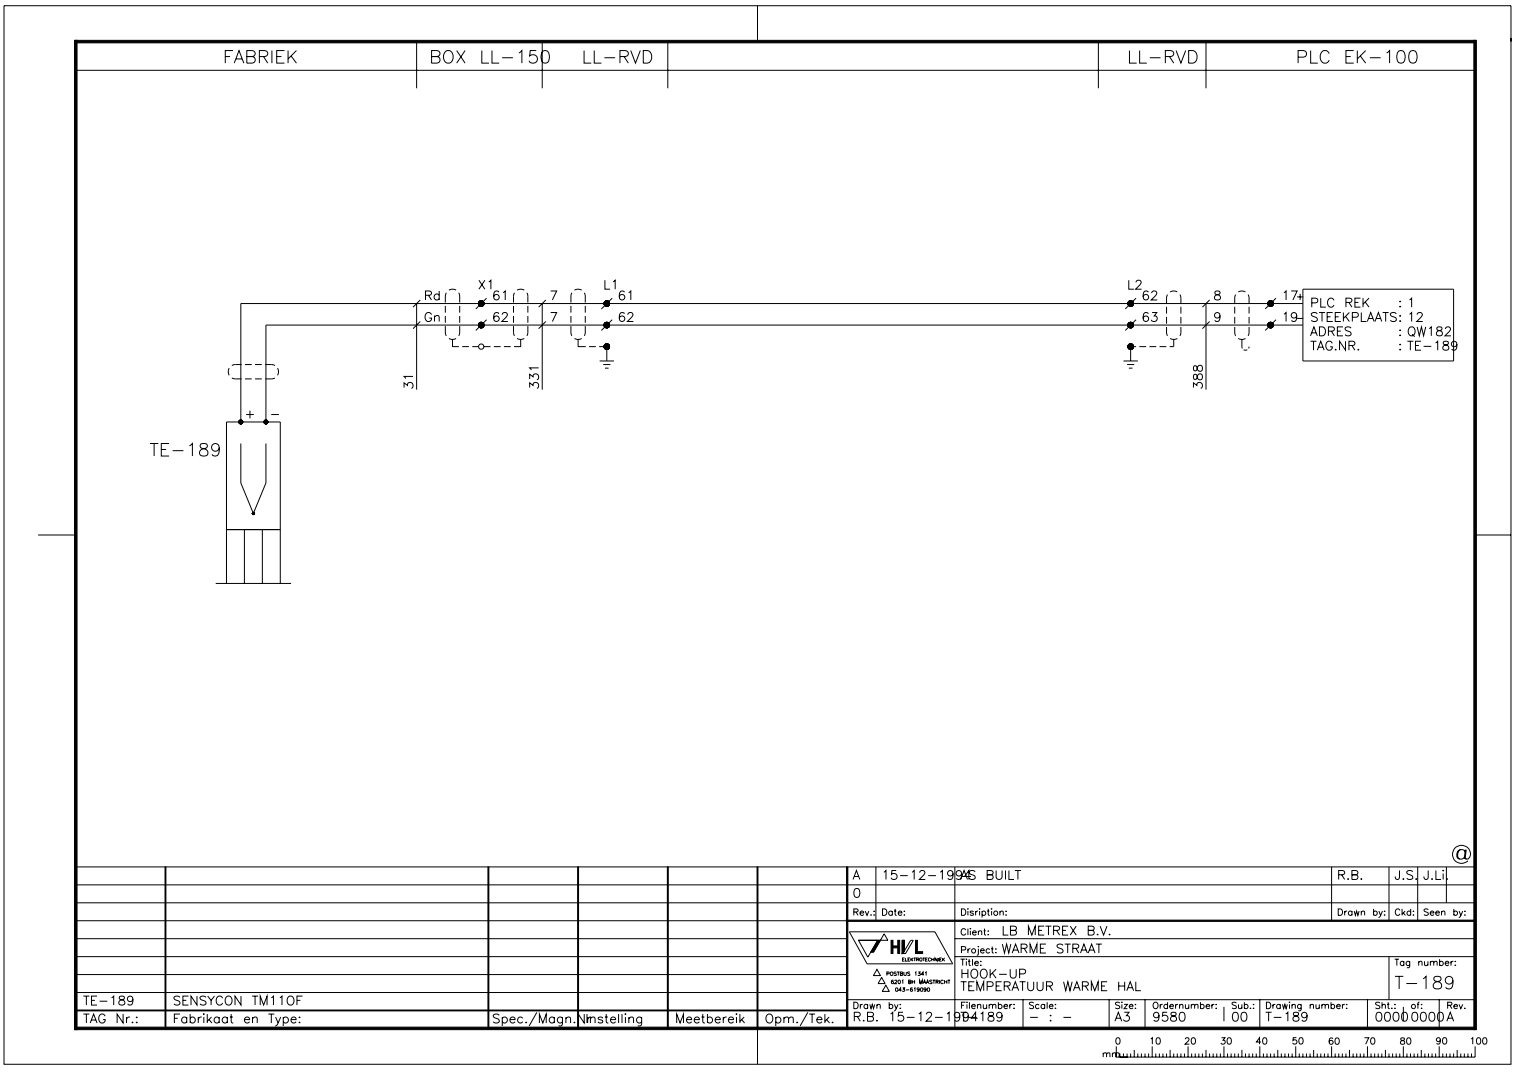

						A	15-12-1994	AS BUILT	R.B.	J.S.	J.Li
						0					
						Rev.:	Date:	Disription:	Drawn by:	Ckd:	Seen by:
						Client: LB METREX B.V.					
						Project: WARME STRAAT					
						Title: HOOK-UP TEMPERATUUR WARME HAL				Tag number: T-189	
TE-189	SENSYCON TM11OF					Drawn by: R.B. 15-12-1994	Filenumber: 189	Scale: - : -	Size: A3	Ordernumber: 9580	Sub.: 00	Drawing number: T-189	Sht.: 0000 of: 0000	Rev. A
TAG Nr.:	Fabrikaat en Type:	Spec./Magn.Nr.	Instelling	Meetbereik	Opm./Tek.						

Demo Version