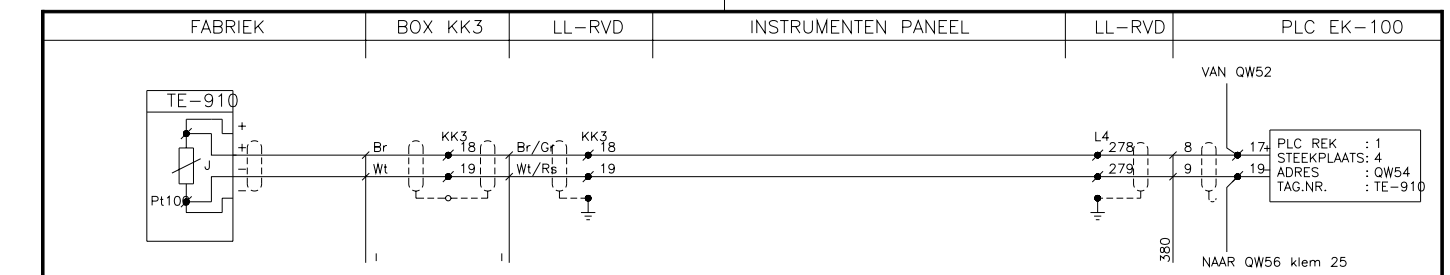

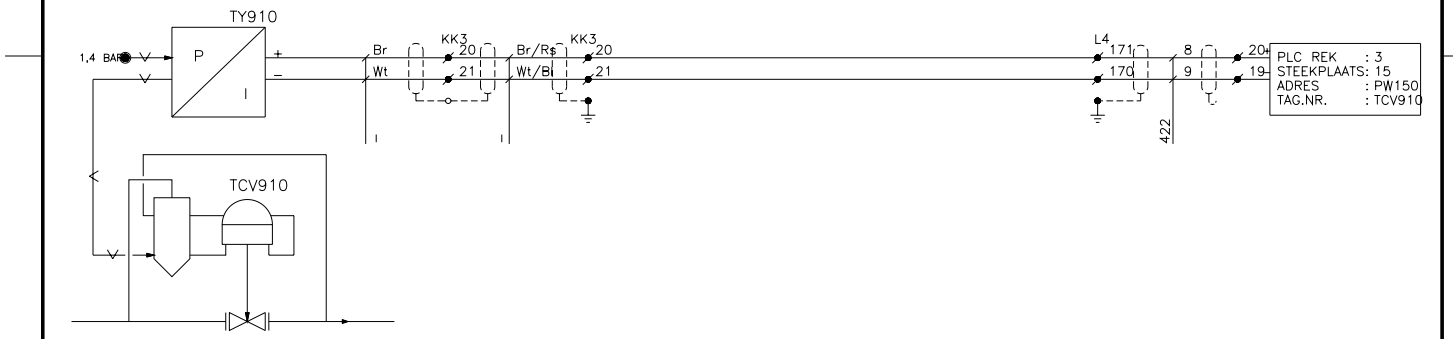

Rev.:	Date:	Disription:	Drawn by:	Ckd:	Seen by:
C	14-12-1994	AS BUILT	N.S.	J.S.	J.Li
B	28-10-1993	SEVERAL CHANGES	R.G.	J.S.	J.Li

TAG Nr.:	Fabrikaat en Type:	Spec./Magn.	Nmstelling	Meetbereik	Opm./Tek.
TCV910	P.U.				
TY910	P.U.				
TE910	SENSYCON TM110F				

HVL ELEKTROTECHNIEK
POSTBUS 1541
6201 BH MAASTRICHT
043-6190390

Client: LB METREX B.V.
Project: ROOKGAS ONTZWAVELING
Title: HOOK-UP KOELWATER IN V910
Tag number: T-910

Drawn by:	Filenumber:	Scale:	Size:	Ordernumber:	Sub.:	Drawing number:	Sht.:	of:	Rev.
M.V. 31-08-1994	94910	- : -	A3	9580	00	3-H-900	00000	00000	C

mm 0 10 20 30 40 50 60 70 80 90 100

Demo Version