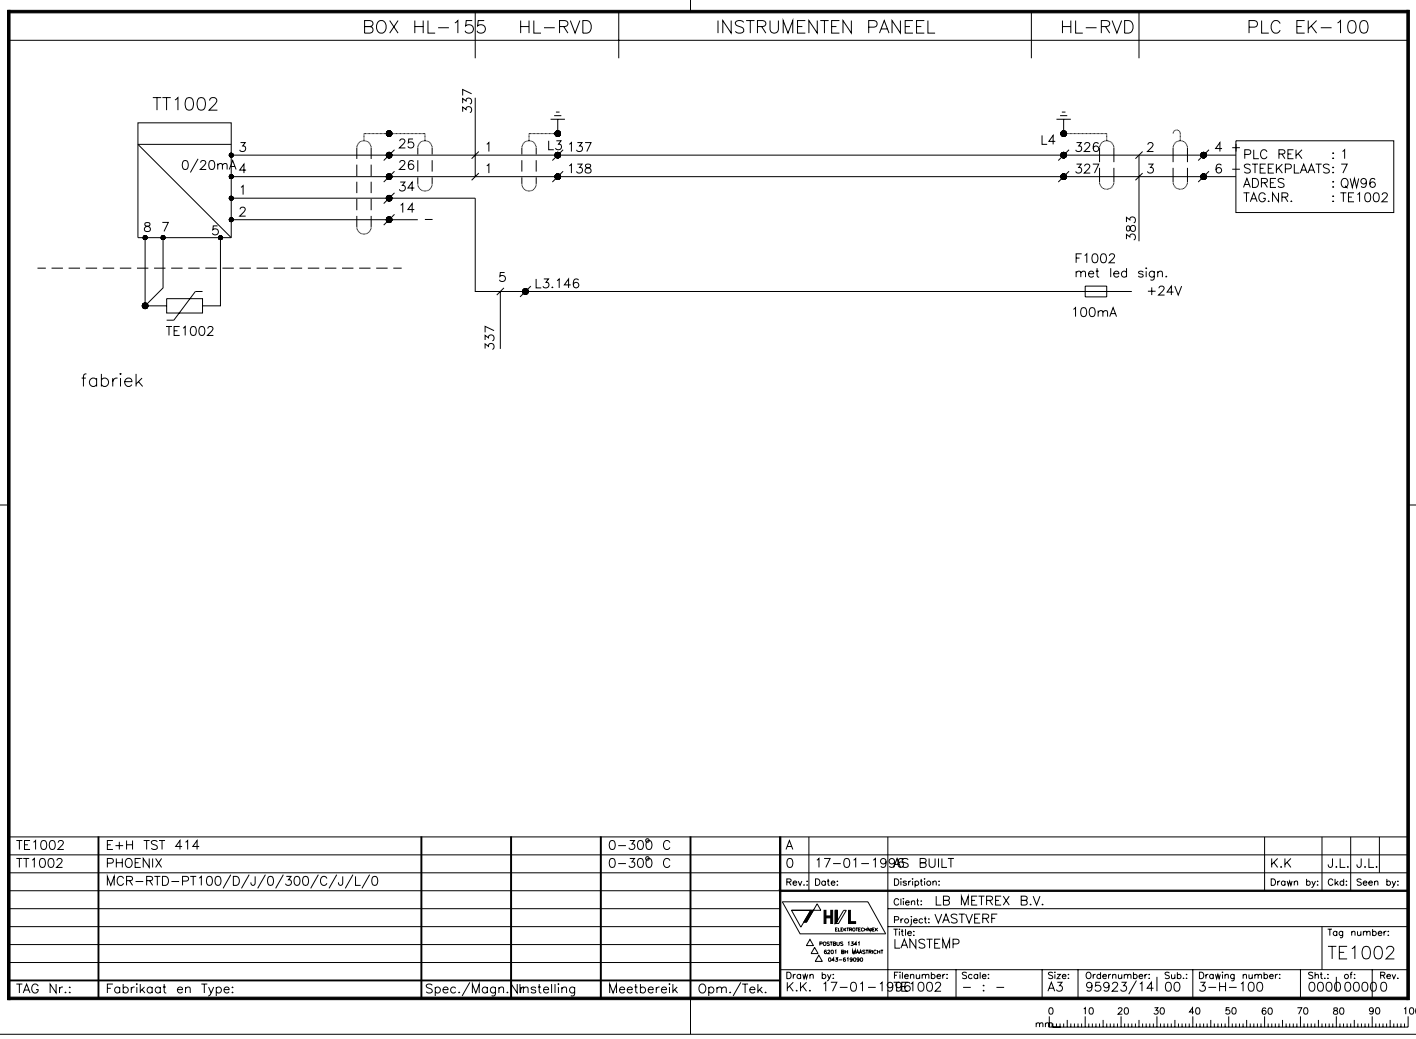

TAG Nr.:	Fabrikaat en Type:	Spec./Magn.	Instelling	Meetbereik	Opm./Tek.
TE1002	E+H TST 414			0-300 C	
TT1002	PHOENIX			0-300 C	
	MCR-RTD-PT100/D/J/0/300/C/J/L/0				

Rev.:	Date:	Disription:	Drawn by:	Ckd:	Seen by:
A					
0	17-01-1995	AS BUILT	K.K	J.L.	J.L.

HVL ELEKTROTECHNIEK
POSTBUS 1341
6201 BH MAASTRICHT
043-618090

Client: LB METREX B.V.
Project: VASTVERF
Title: LANSTEMP
Tag number: TE1002

Drawn by:	Filenumber:	Scale:	Size:	Ordernumber:	Sub.:	Drawing number:	Sht.:	of:	Rev.
K.K. 17-01-1995	TE1002	- : -	A3	95923/14	00	3-H-100	00	00	0

0 10 20 30 40 50 60 70 80 90 100 mm

Demo Version