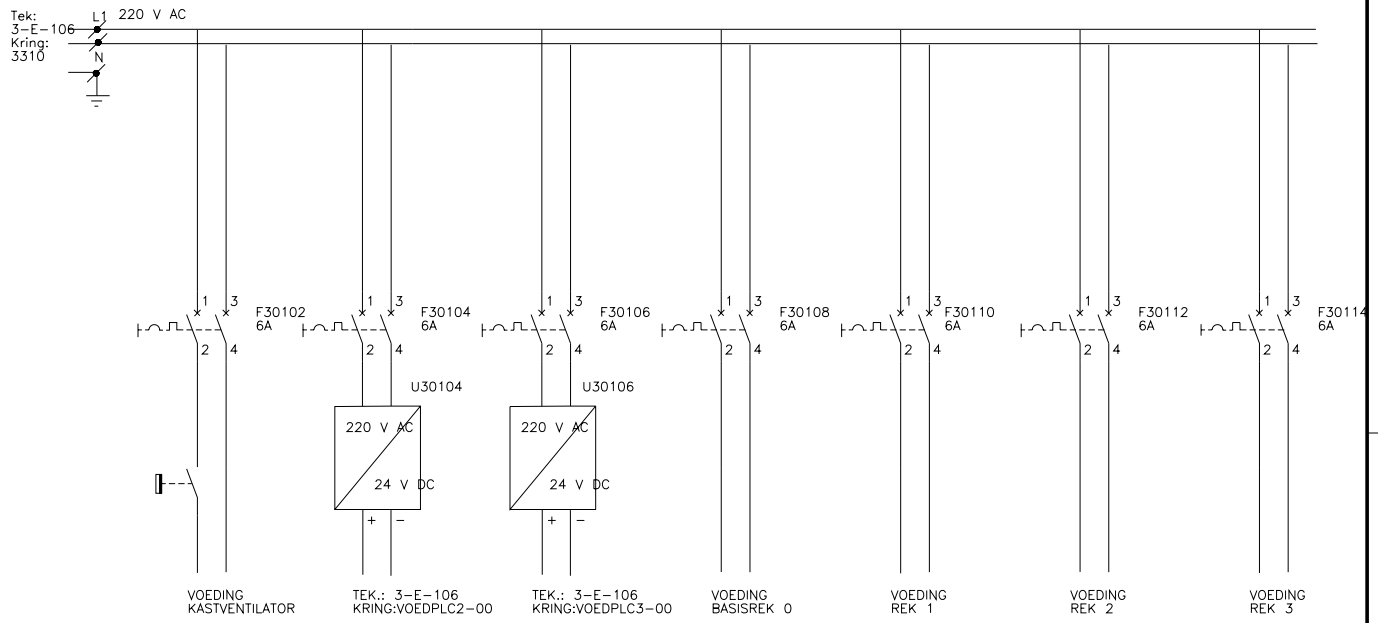

Rev.:	Date:	Disription:	Drawn by:	Ckd:	Seen by:
A	16-12-1994	AS BUILT	P.G.	J.S.	J.Li

HVL ELEKTROTECHNIEK
POSTBUS 1541
6201 BH MAASTRICHT
043-6190190

Client: LB METREX B.V.
Project: WARME STRAAT
Title: 220 V AC VOEDINGSVERDELING IN PLC KAST (PACKAGE UNIT) F
Tag number: VOEDPLC1

Drawn by:	Filenumber:	Scale:	Size:	Ordernumber:	Sub.:	Drawing number:	Sht.:	of:	Rev.
P.G.	VOEDPLC1	- : -	A3	9580	00	3-E-106	0000	0000	A

TY-M3

Demo Version