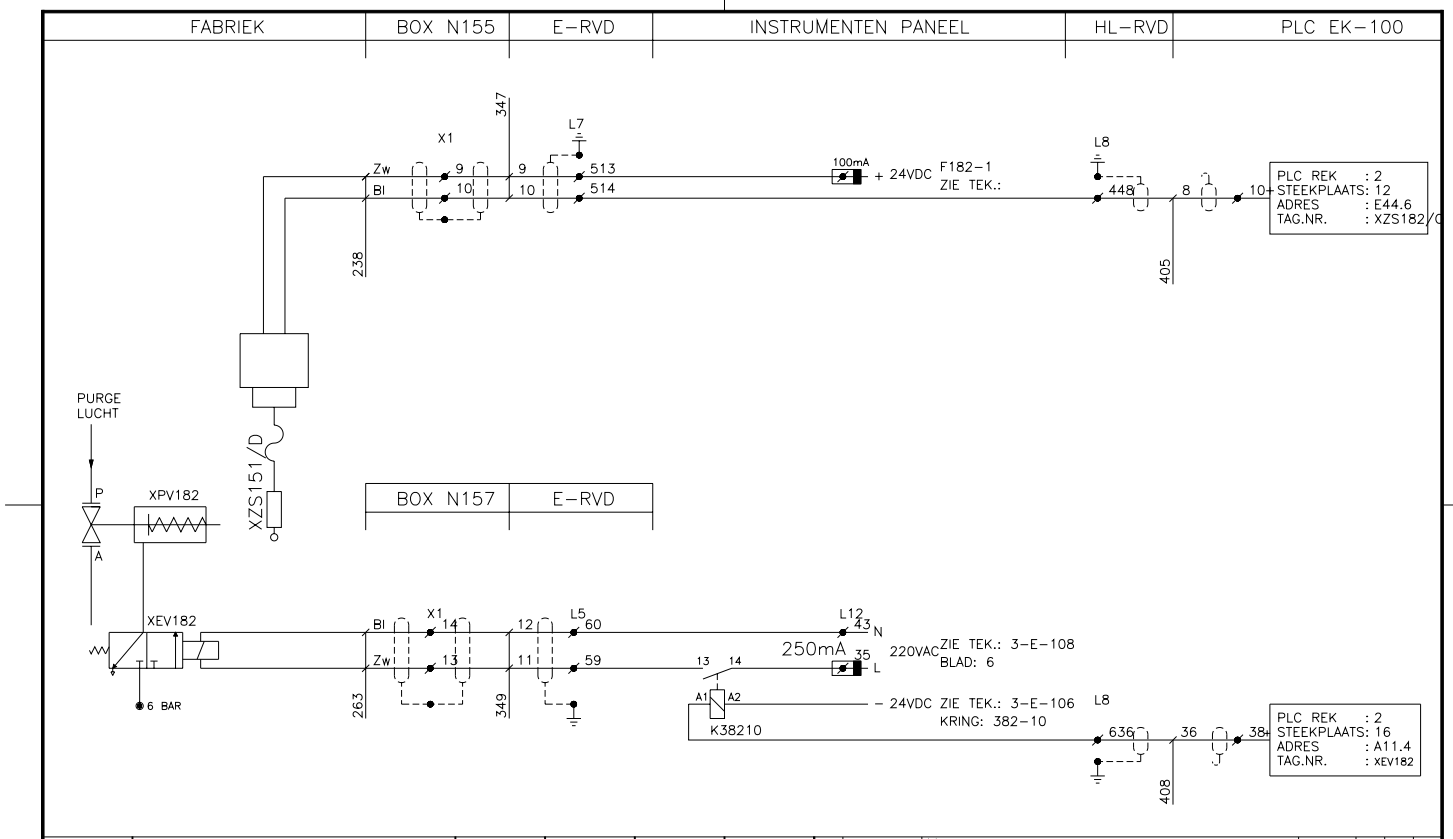

Rev.:	Date:	Disription:	Drawn by:	Ckd:	Seen by:
A	09-09-1994	N.V.	J.S.	J.Li	
B	15-12-1994	AS BUILT	P.G	J.S.	J.Li

TAG Nr.:	Fabrikaat en Type:	Spec./Magn.	Nmstelling	Meetbereik	Opm./Tek.
XZS182	HONEYWELL EEXd 70C76				
XEV182	SEMPRESS 4551607				
XPV182	CUPEDO R9048-000-001				

HVL ELEKTROTECHNIEK
POSTBUS 1341
6201 BH MAASTRICHT
043-6190390

Client: LB METREX B.V.
Project: WARME STRAAT
Title: HOOK-UP
KLEP OMLOOP CIRCULATIEPOMP P-150
Tag number: X-182

Drawn by:	Filenumber:	Scale:	Size:	Ordernumber:	Sub.:	Drawing number:	Sht.:	of:	Rev.
P.G 15-12-1994	4-182	- : -	A4	9580	00	3-H-100	00000	00000	0

mm 0 10 20 30 40 50 60 70 80 90 100

Demo Version