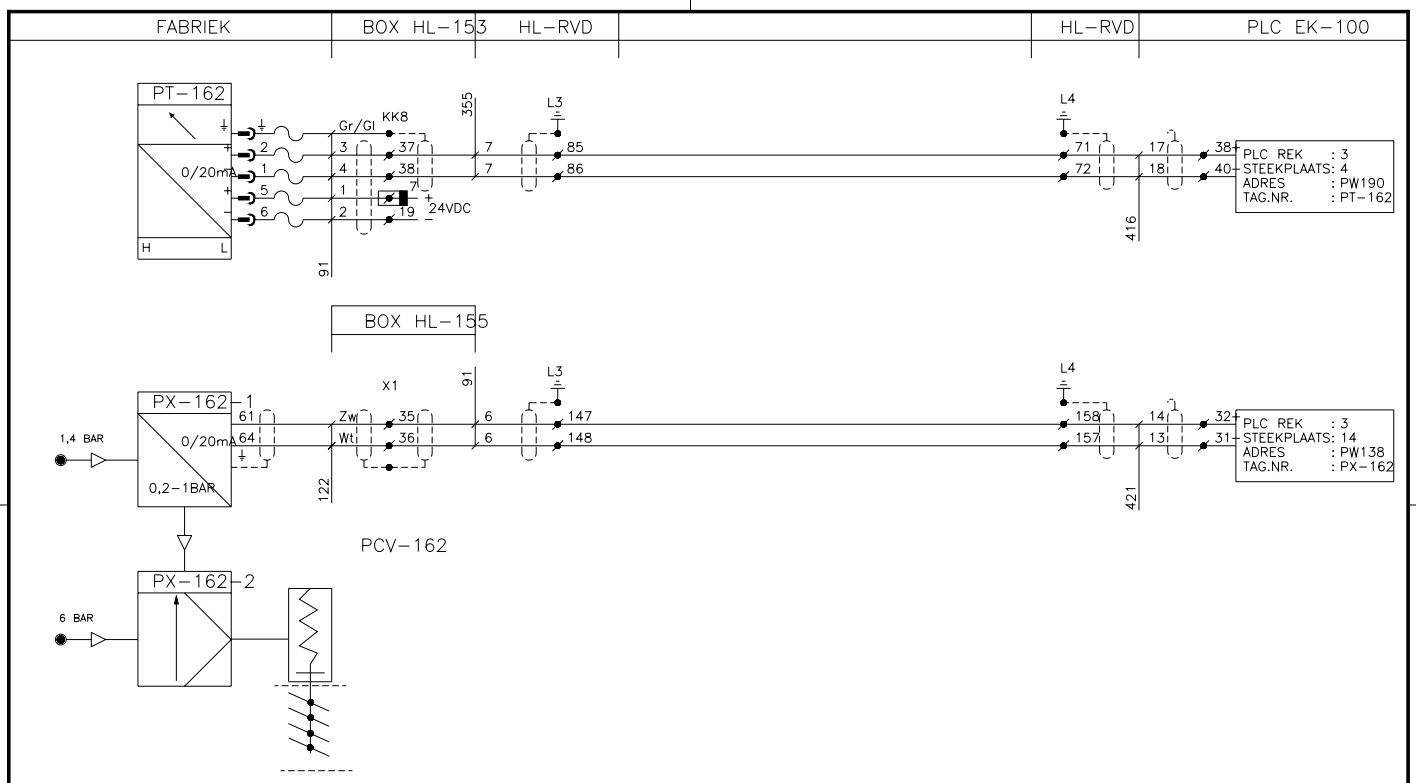

TAG Nr.:	Fabrikaat en Type:	Spec./Magn.	Nmstelling	Meetbereik	Opm./Tek.
PCV-162	LIEBFRIED LCZM 4462602-0240	404			
PX-162-2	MOORE 40126-32	404	0,2-1 BAR		
PX-162-1	H & B TEIP (18410-0-4131100)	132	0,2-1 BAR	0-20 mA	
PT-162	H & B CMR 15200	118	-10...+10mBAR	0-25 mBAR	

Rev.:	Date:	Disription:	Drawn by:	Ckd:	Seen by:
A	19-07-1994	FOR APPROVAL	M.F	J.S	J.Li
B	15-12-1994	AS BUILT	P.G.	J.S.	J.Li

HVL ELEKTROTECHNIEK
POSTBUS 1341
6201 BH MAASTRICHT
043-6190390

Client: LB METREX B.V.
Project: WARME STRAAT
Title: HOOK-UP VUURHAARDDRUKREGELING
Tag number: P-162

Drawn by:	Filenumber:	Scale:	Size:	Ordernumber:	Sub.:	Drawing number:	Sht.:	of:	Rev.
P.G 15-12-1994	P-162	- : -	A4	9580	00	3-H-100	00000	00000	B

Demo Version