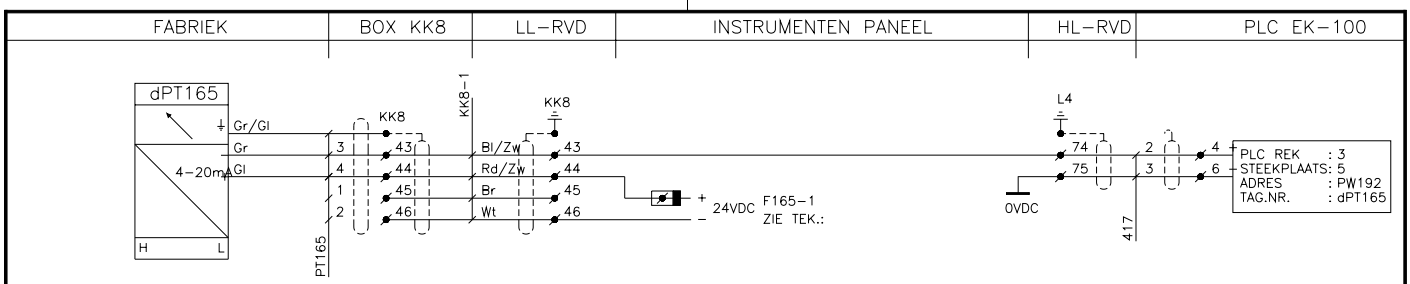

dPT165	YOKOGAWA	119	0-50 mBAR	0-100 mBAR	
TAG Nr.:	Fabrikaat en Type:	Spec./Magn.	Nmstelling	Meetbereik	Opm./Tek.

Rev.:	Date:	Disription:	Drawn by:	Ckd:	Seen by:
C	22-09-1995	SEVERAL CHANGES	R.B.	J.Le	J.Le.
B	15-12-1994	AS BUILT	P.G	J.S.	J.Li

HVL ELEKTROTECHNIEK
POSTBUS 1541
6201 BH MAASTRICHT
043-6190190

Client: LB METREX B.V.
Project: WARME STRAAT
Title: HOOK-UP
dP VLIEGAS CYCLOON S-150
Tag number: P-165

Drawn by:	Filenumber:	Scale:	Size:	Ordernumber:	Sub.:	Drawing number:	Sht.:	of:	Rev.
P.G 15-12-1994	P-165	- : -	A4	9580	00	3-H-100	00000	00000	C

mm 0 10 20 30 40 50 60 70 80 90 100

Demo Version