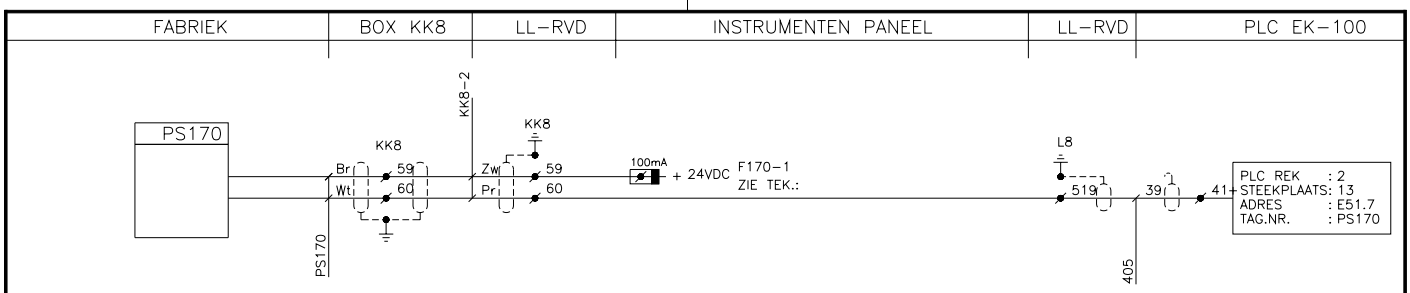

PS170	SATCHWELL UH 2206			0,6-6,0 BAR	
TAG Nr.:	Fabrikaat en Type:	Spec./Magn.	Nmstelling	Meetbereik	Opm./Tek.

Rev.:	Date:	Disription:	Drawn by:	Ckd:	Seen by:
A	13-09-1994	FOR APPROVAL	M.V.	J.S	J.Li
B	14-09-1994	AS BUILT	P.G	J.S.	J.Li

HVL ELEKTROTECHNIEK
POSTBUS 1341
6201 BH MAASTRICHT
043-6116090

Client: LB METREX B.V.
Project: WARME STRAAT
Title: HOOK-UP
PS SPOELLUCHT DOEKENFILTER F-150
Tag number: P-170

Drawn by:	Filenumber:	Scale:	Size:	Ordernumber:	Sub.:	Drawing number:	Sht.:	of:	Rev.
P.G.15-12-1994	P-170	- : -	A4	9580	00	3-H-100	00000	00000	B

0 10 20 30 40 50 60 70 80 90 100 mm

Demo Version