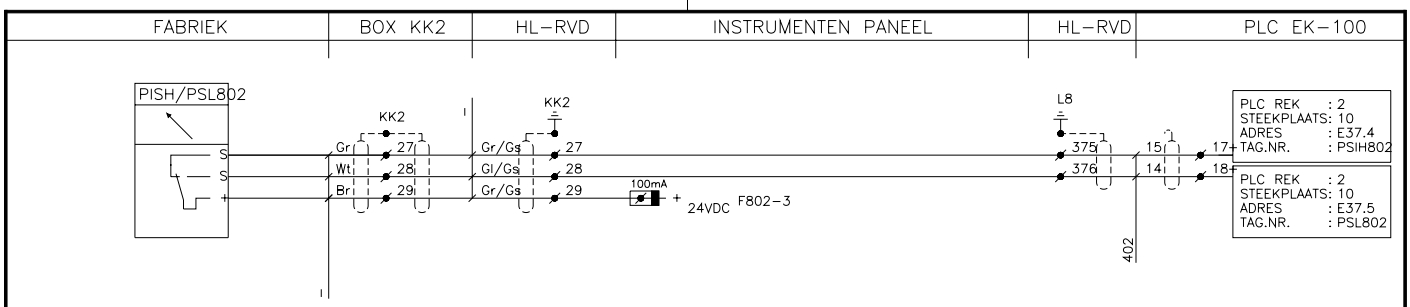

PSL802	ERIKS TYPE: M 1e sluit				
PISH802	ERIKS FIG1407 TYPE: M 2e opent				
TAG Nr.:	Fabrikaat en Type:	Spec./Magn.	Instelling	Meetbereik	Opm./Tek.

Rev.:	Date:	Disription:	Drawn by:	Ckd:	Seen by:
A	24-10-1994	SEVERAL CHANGES	R.G.	J.S.	J.Li
B	14-12-1994	AS BUILT	N.S.	J.S.	J.Li

HVL ELEKTROTECHNIEK
POSTBUS 1541
6201 BH MAASTRICHT
043-6190190

Client: LB METREX B.V.
Project: ROOKGAS ONTZWAVELING
Title: HOOK-UP
PERS HYDROXIDE POMPEN P802A/B
Tag number: P-802

Drawn by:	Filenumber:	Scale:	Size:	Ordernumber:	Sub.:	Drawing number:	Sht.:	of:	Rev.
R.G. 18-08-1994	802	- : -	A3	9580	00	3-H-800	0000	0000	B

mm 0 10 20 30 40 50 60 70 80 90 100

Demo Version