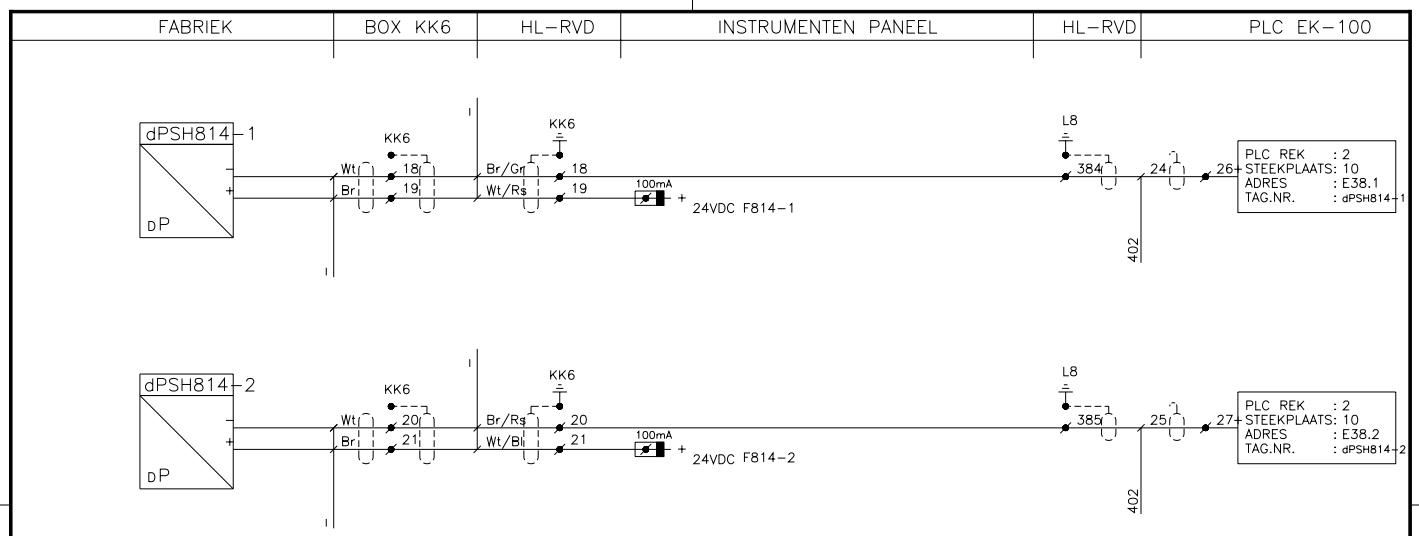

Rev.	Date:	Disription:	Drawn by:	Ckd:	Seen by:
A	26-10-1993	SEVERAL CHANGES	R.G.	J.S.	J.Li
B	14-12-1994	AS BUILT	N.S.	J.S.	J.Li

TAG Nr.:	Fabrikaat en Type:	Spec./Magn.Instelling	Meetbereik	Opm./Tek.
dPSH814-2	INTRA AUTOMATION			
dPSH814-1	INTRA AUTOMATION			

HVL ELEKTROTECHNIEK
POSTBUS 1341
6201 BH MAASTRICHT
043-618090

Client: LB METREX B.V.
Project: ROOKGAS ONTZWAVELING
Title: HOOK-UP
DIMISTER VAN SCRUBBER C815 IN ZE WARMTE WISSELAAR E815 IN Z815
Tag number: P-814

Drawn by:	Filenumber:	Scale:	Size:	Ordernumber:	Sub.:	Drawing number:	Sht.:	of:	Rev.
R.G. 23-08-1994	814	– : –	A3	9580	00	3-H-800	00	00	B

mm 0 10 20 30 40 50 60 70 80 90 100

Demo Version