FABRIEK	BOX KK5	HL-RVD	INSTRUMENTEN PANEEL	HL-RVD	PLC EK-100

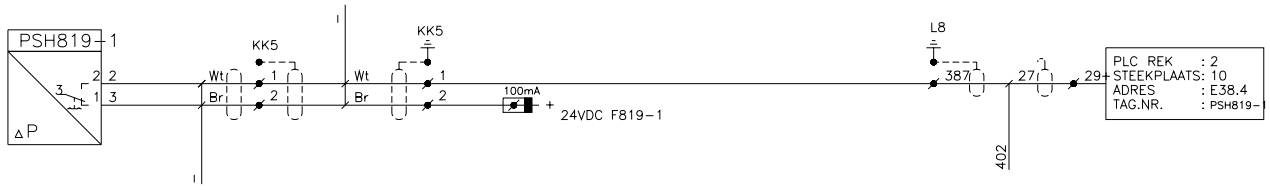

PSH819-1	FEMA DCM 3-351 9433		?	0,1-2,5BAR	
TAG Nr.:	Fabrikaat en Type:	Spec./Magn.	Nmstelling	Meetbereik	Opm./Tek.

Rev.:	Date:	Disription:	Drawn by:	Ckd:	Seen by:
A	14-12-1994	AS BUILT	N.S.	J.S.	J.Li
0	23-08-1994	FOR APPROVAL	R.G.	J.S.	J.Li

HVL ELEKTROTECHNIEK
POSTBUS 1541
6201 BH MAASTRICHT
043-6190390

Client: LB METREX B.V.
Project: ROOKGAS ONTZWAVELING
Title: HOOK-UP
PERS POSTOXIDATIE VENTILATOR K819
Tag number: P-819

Drawn by:	Filenumber:	Scale:	Size:	Ordernumber:	Sub.:	Drawing number:	Sht.:	of:	Rev.
R.G. 23-08-1994	94819	- : -	A3	9580	00	3-H-800	0000	0000	A

0 10 20 30 40 50 60 70 80 90 100 mm

Demo Version