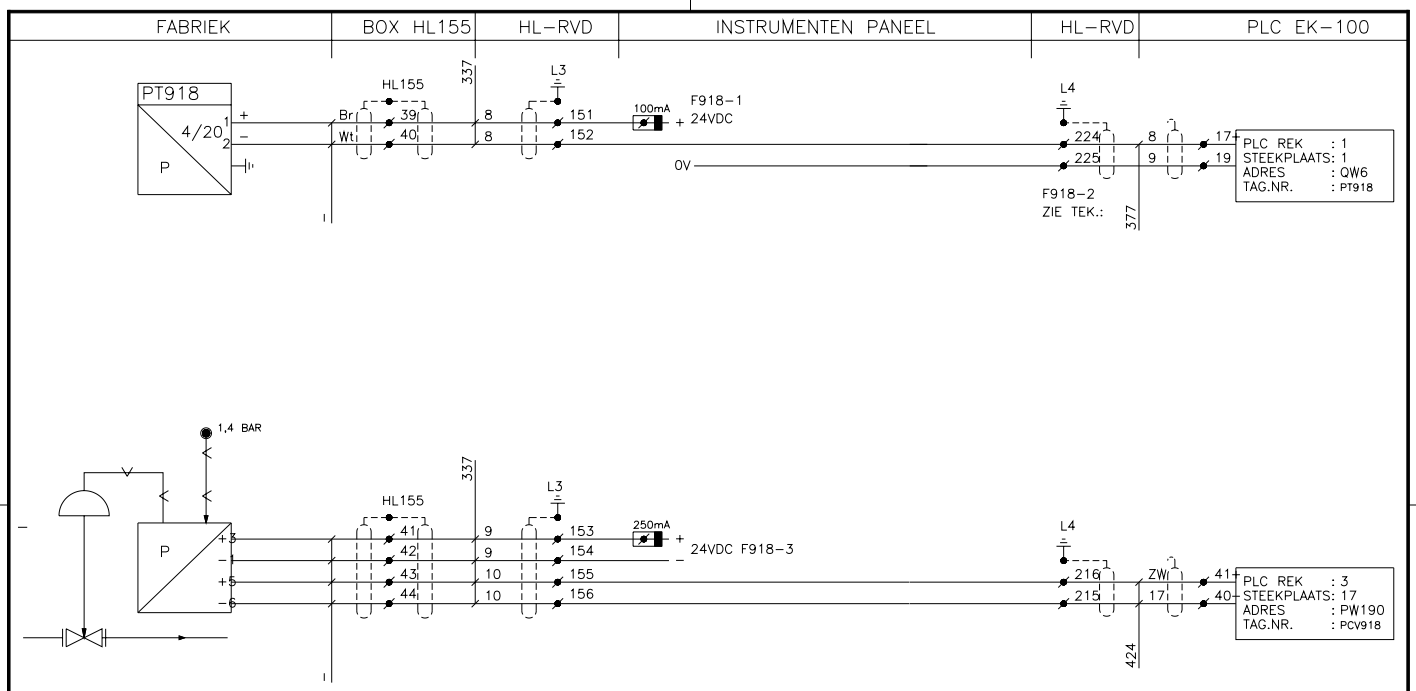

Rev.:	Date:	Disription:	Drawn by:	Ckd:	Seen by:
A	26-10-1993	SEVERAL CHANGES	R.G.	J.S.	J.Li
B	14-12-1994	AS BUILT	N.S.	J.S.	J.Li

TAG Nr.:	Fabrikaat en Type:	Spec./Magn.	Nmstelling	Meetbereik	Opm./Tek.
PCV918	HONEYWEL LUCIFER EPP34CC				
PT918	SAMSON CB1020				

HVL ELEKTROTECHNIEK
POSTBUS 1341
6201 BH MAASTRICHT
043-6190190

Client: LB METREX B.V.
Project: ROOKGAS ONTZWAVELING
Title: HOOK-UP PERSLUCHT REGELING V-169
Tag number: P-918

Drawn by:	Filenumber:	Scale:	Size:	Ordernumber:	Sub.:	Drawing number:	Sht.:	of:	Rev.
M.V. 30-08-1994	94918	- : -	A3	9580	00	3-H-900	00000	00000	B

mm 0 10 20 30 40 50 60 70 80 90 100

Demo Version