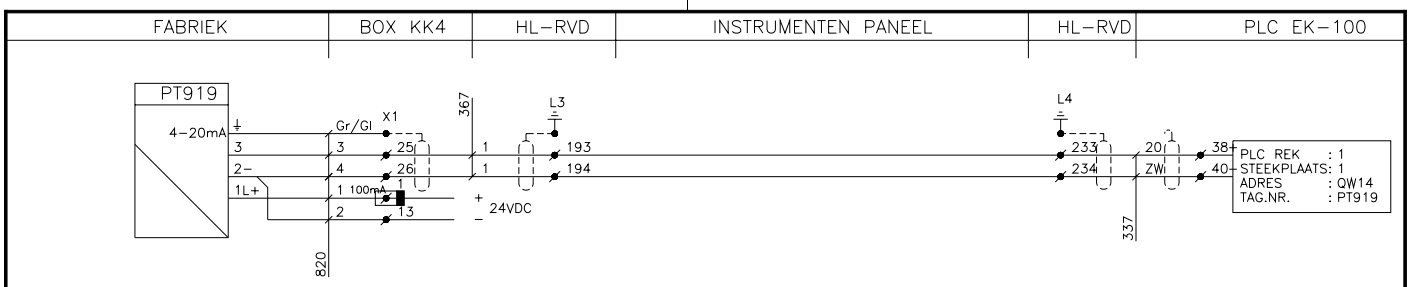

Rev.:	Date:	Disription:	Drawn by:	Ckd:	Seen by:
A	14-12-1994	AS BUILT	N.S.	J.S.	J.Li

HVL ELEKTROTECHNIEK
POSTBUS 1541
6201 BH MAASTRICHT
043-6116090

Client: LB METREX B.V.
Project: ROOKGAS ONTZWAVELING
Title: HOOK-UP
WREKLUCHTDRUCK COMPRESSOR MK172
Tag number: PT919

Drawn by:	Filenumber:	Scale:	Size:	Ordernumber:	Sub.:	Drawing number:	Sht.:	of:	Rev.
N.S. 14-12-1994	PT919	- : -	A3	9580	00	3-H-800	00000	00000	A

TAG Nr.:	Fabrikaat en Type:	Spec./Magn.	Nmstelling	Meetbereik	Opm./Tek.
PT919	JUMO 4AP-30-420			0-16 BAR	

mm 0 10 20 30 40 50 60 70 80 90 100

Demo Version