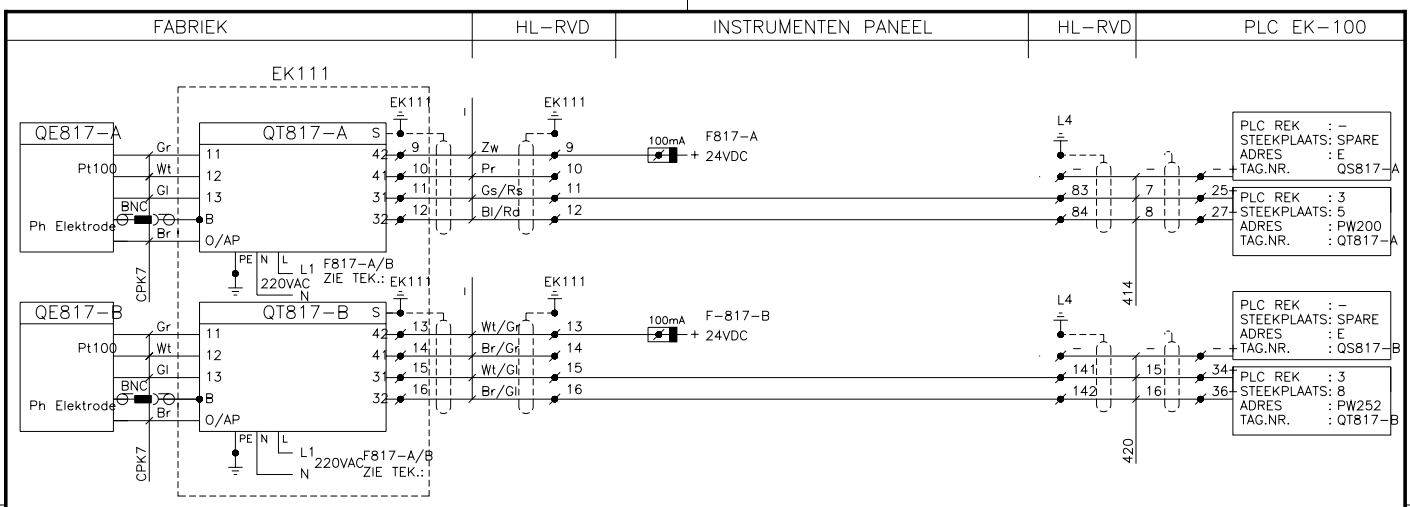

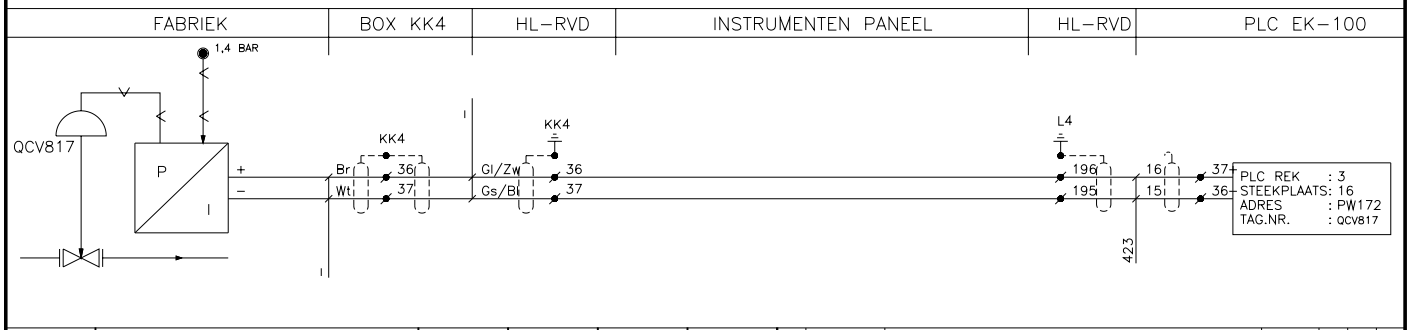

QCV817	+GF+ 021				
QT817B	E&H CPM 121 – P11A00				
QE817B	E&H CPA 250-A				
QT817A	E&H CPM 121 – P11A00				
QE817A	E&H CPA 250-A				
TAG Nr.:	Fabrikaat en Type:	Spec./Magn.	Nmstelling	Meetbereik	Opm./Tek.

Rev.:	Date:	Disription:	Drawn by:	Ckd:	Seen by:
A	26-10-1993	SEVERAL CHANGES	R.G.	J.S.	J.Li
B	14-12-1994	AS BUILT	N.S.	J.S.	J.Li

HVL ELEKTROTECHNIEK
POSTBUS 1541
6201 BH MAASTRICHT
043-6196090

Client: LB METREX B.V.
Project: ROOKGAS ONTZWAVELING
Title: HOOK-UP
Ph AFVOER KOLOM C817

Tag number: Q-817

Drawn by:	Filenumber:	Scale:	Size:	Ordernumber:	Sub.:	Drawing number:	Sht.:	of:	Rev.
R.G. 18-08-1994	Q-817	– : –	A3	9580	00	3-H-800	0000	0000	B

0 10 20 30 40 50 60 70 80 90 100 mm

Demo Version