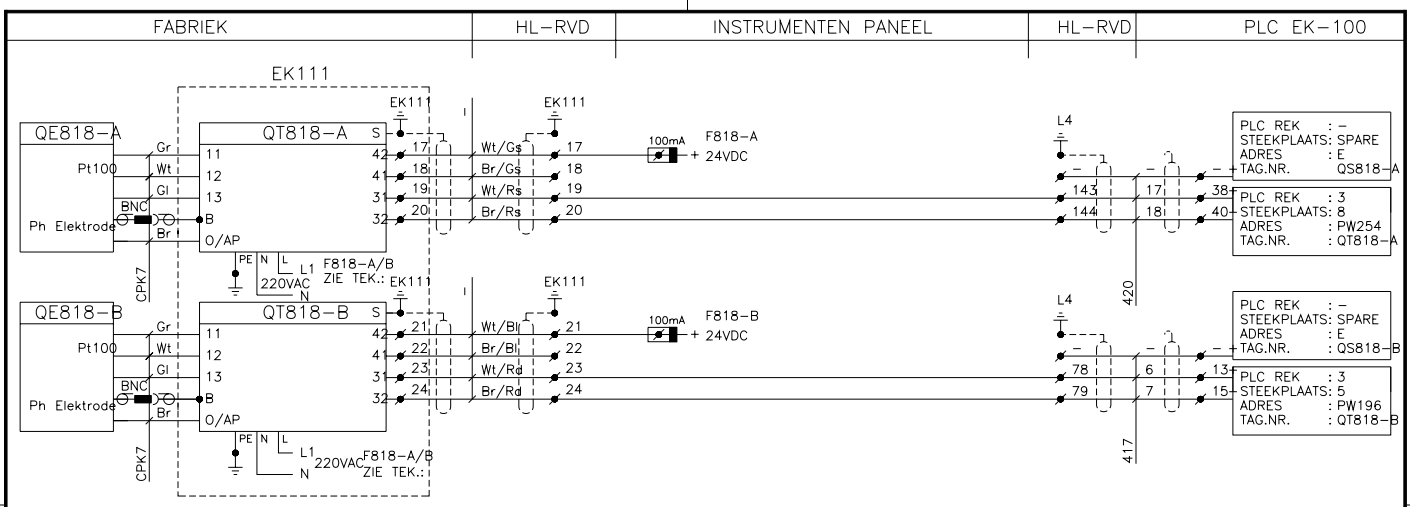

Rev.:	Date:	Disription:	Drawn by:	Ckd:	Seen by:
A	26-10-1993	SEVERAL CHANGES	R.G.	J.S.	J.Li
B	14-12-1994	AS BUILT	N.S.	J.S.	J.Li

TAG Nr.:	Fabrikaat en Type:	Spec./Magn.	Nmstelling	Meetbereik	Opm./Tek.
QCV818	+GF+ 021				
QT818B	E&H CPM 121 - P11A00				
QE818B	E&H CPA 250-A				
QT818A	E&H CPM 121 - P11A00				
QE818A	E&H CPA 250-A				

HVL ELEKTROTECHNIEK
POSTBUS 1541
6201 BH MAASTRICHT
043-6116090

Client: LB METREX B.V.
Project: ROOKGAS ONTZWAVELING
Title: HOOK-UP PH AFVOER KOLOM C818
Tag number: Q-818

Drawn by:	Filenumber:	Scale:	Size:	Ordernumber:	Sub.:	Drawing number:	Sht.:	of:	Rev.
R.G. 18-08-1994	Q-818	- : -	A3	9580	00	3-H-800	0000	0000	B

0 10 20 30 40 50 60 70 80 90 100 mm

Demo Version