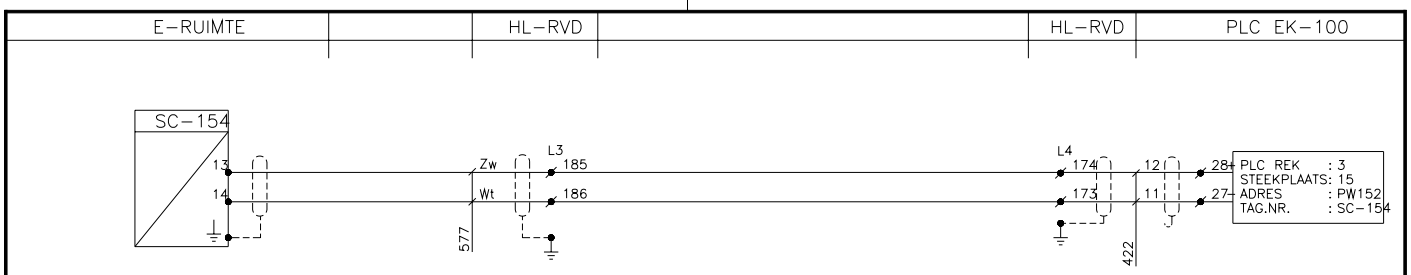

OPMERK.: PANEEL U603

SC-154	STROMBERG HOP S21				
TAG Nr.:	Fabrikaat en Type:	Spec./Magn.	Nmstelling	Meetbereik	Opm./Tek.

Rev.:	Date:	Disription:	Drawn by:	Ckd:	Seen by:
A	31-12-1994	AS BUILT	N.S.	J.S.	J.Li

HVL ELEKTROTECHNIEK
POSTBUS 1541
6201 BH MAASTRICHT
043-6190190

Client: LB METREX B.V.
Project: ROOKGAS ONTZWAVELING
Title: TOERENREGELING VERBRANDINGSLUCHTVENTILATOR (MK150)
Tag number: S-154

Drawn by:	Filenumber:	Scale:	Size:	Ordernumber:	Sub.:	Drawing number:	Sht.:	of:	Rev.
N.S. 13-12-1994	154	- : -	A3	9580	00	3-H-100	00000	00000	A

0 10 20 30 40 50 60 70 80 90 100 mm

Demo Version