P607A(MCC)		HL-RVD		HL-RVD	PLC EK-100

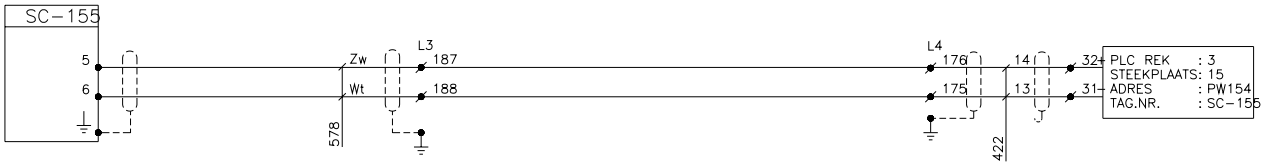

ZIE VERDER TEK. 3-E-106
BLAD 7 KRING 06

Rev.:	Date:	Disription:	Drawn by:	Ckd:	Seen by:
A	31-12-1994	AS BUILT	N.S.	J.S.	J.Li

HVL ELEKTROTECHNIEK
POSTBUS 1541
6201 BH MAASTRICHT
043-6190190

Client: LB METREX B.V.
Project: ROOKGAS ONTZWAVELING
Title: TOERENREGELING BLOWER MK158
Tag number: S-155

Drawn by:	Filenumber:	Scale:	Size:	Ordernumber:	Sub.:	Drawing number:	Sht.:	of:	Rev.
N.S. 13-12-1994	94155	- : -	A3	9580	00	3-H-100	00000	00000	A

SC-155	SAMI MINI STAR 17MB-4M2				
TAG Nr.:	Fabrikaat en Type:	Spec./Magn.	Nmstelling	Meetbereik	Opm./Tek.

0 10 20 30 40 50 60 70 80 90 100 mm

Demo Version