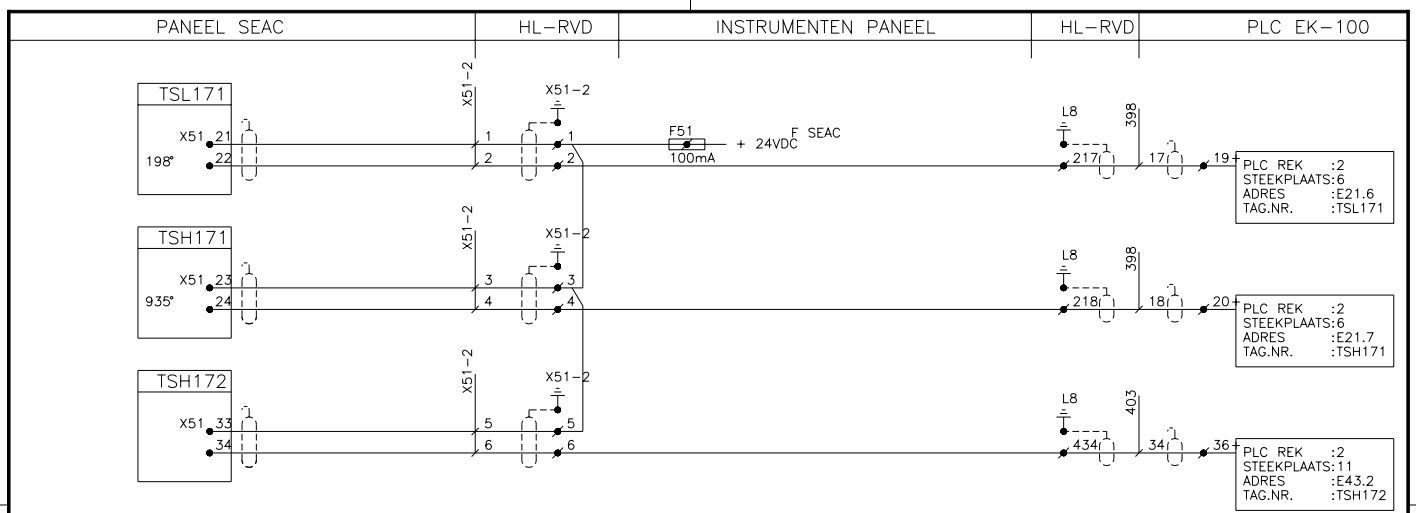

TAG Nr.:	Fabrikaat en Type:	Spec./Magn.Instelling	Meetbereik	Opm./Tek.
TSH172	T-UITLAAT ALARMEENHEID			
TSH71	T-INLAAT ALARMEENHEID			
TSL71	T-INLAAT ALARMEENHEID			

Rev.	Date:	Disription:	Drawn by:	Ckd:	Seen by:
A	07-11-1994	SEVERAL CHANGES	R.G.	J.S.	J.Li
B	16-12-1994	AS BUILT	P.G.	J.S.	J.Li

HVL ELEKTROTECHNIEK
POSTBUS 1341
6201 BH MAASTRICHT
043-618090

Client: LB METREX B.V.
Project: WARME STRAAT
Title: HOOK-UP SEAC INTERFACE
Tag number: SEAC10

Drawn by:	Filenumber:	Scale:	Size:	Ordernumber:	Sub.:	Drawing number:	Sht.:	of:	Rev.
M.V. 13-09-1994	SEAC10	- : -	A4	9580	00	3-H-100	00000	0000	B

0 10 20 30 40 50 60 70 80 90 100 mm

Demo Version