PANEEL SEAC	HL-RVD	INSTRUMENTEN PANEEL	HL-RVD	PLC EK-100

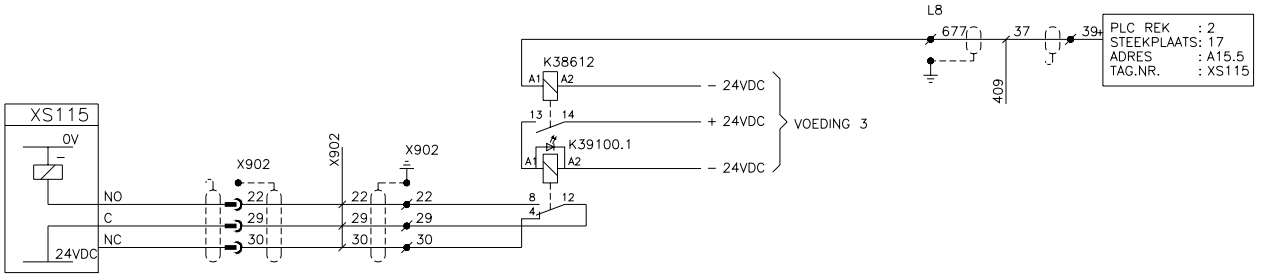

VOOR X902: Zie Tek. 470.X902 "SEAC PAKKET"

Rev.:	Date:	Disription:	Drawn by:	Ckd:	Seen by:
A	07-11-1993	SEVERAL CHANGES	R.G.	J.S.	J.Li
B	16-12-1994	AS BUILT	P.G.	J.S.	J.Li

HVL ELEKTROTECHNIEK
POSTBUS 1341
6201 BH MAASTRICHT
043-6190190

Client: LB METREX B.V.
Project: WARME STRAAT
Title: HOOK-UP
SEAC INTERFACE X902 BLAD. 3
Tag number: SEAC3

Drawn by:	Filenumber:	Scale:	Size:	Ordernumber:	Sub.:	Drawing number:	Sht.:	of:	Rev.
M.V. 13-09-1994	SEAC9023	- : -	A4	9580	00	3-H-100	00000	00000	B

XS115	START				
TAG Nr.:	Fabrikaat en Type:	Spec./Magn.	Instelling	Meetbereik	Opm./Tek.

0 10 20 30 40 50 60 70 80 90 100 mm

Demo Version