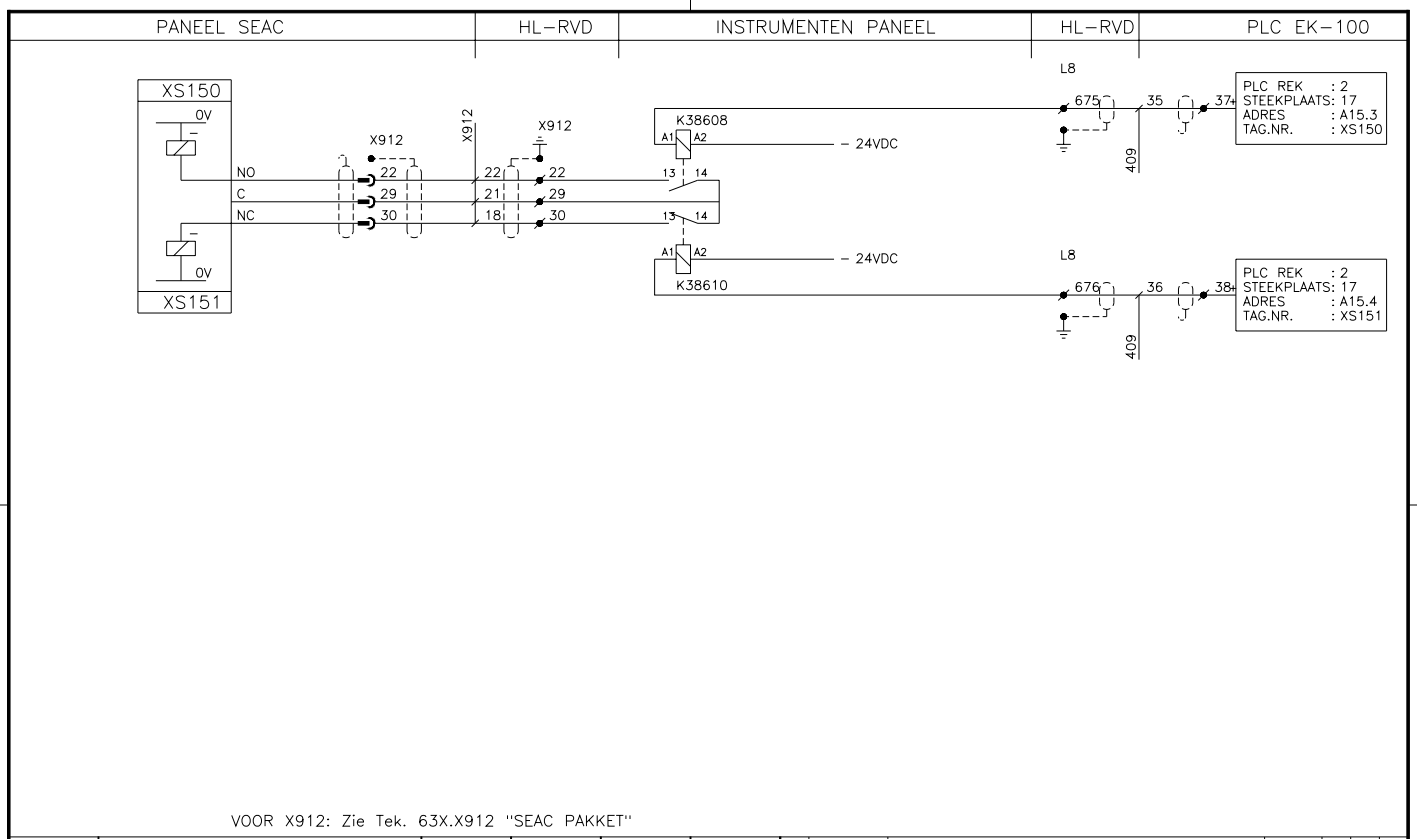

VOOR X912: Zie Tek. 63X.X912 "SEAC PAKKET"

XS151	STOP				
XS150	START				
TAG Nr.:	Fabrikaat en Type:	Spec./Magn.	Instelling	Meetbereik	Opm./Tek.

Rev.:	Date:	Disription:	Drawn by:	Ckd:	Seen by:
A	07-11-1994	SEVERAL CHANGES	R.G.	J.S.	J.Li
B	15-12-1994	AS BUILT	P.G	J.S.	J.Li

HVL ELEKTROTECHNIEK
POSTBUS 1341
6201 BH MAASTRICHT
043-618090

Client: LB METREX B.V.
Project: WARME STRAAT
Title: HOOK-UP
SEAC INTERFACE X912 BLAD. 3
Tag number: SEAC6

Drawn by:	Filenumber:	Scale:	Size:	Ordernumber:	Sub.:	Drawing number:	Sht.: of:	Rev.
M.V. 13-09-1994	SEAC9123	- : -	A4	9580	00	3-H-100	00000000	B

0 10 20 30 40 50 60 70 80 90 100 mm

Demo Version