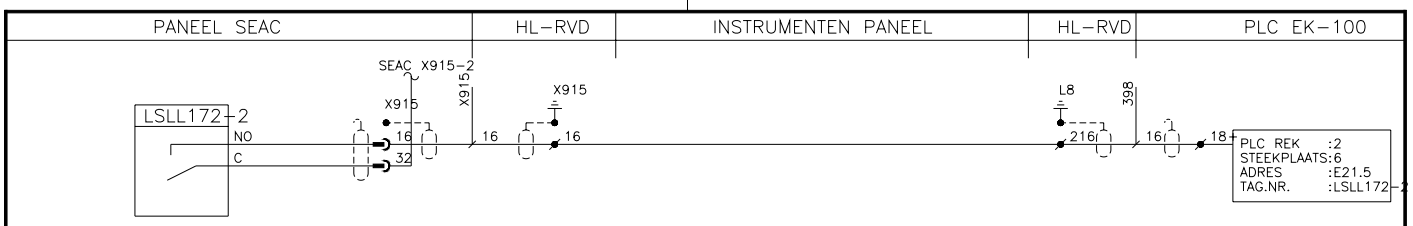

VOOR X915: Zie Tek. 63X.XX915 "SEAC PAKKET"

LSLL172-2	TANK LEEG				
TAG Nr.:	Fabrikaat en Type:	Spec./Magn.	Instelling	Meetbereik	Opm./Tek.

Rev.:	Date:	Disription:	Drawn by:	Ckd:	Seen by:
A	07-11-1993	SEVERAL CHANGES	R.G.	J.S.	J.Li
B	16-12-1994	AS BUILT	P.G.	J.S.	J.Li

HVL ELEKTROTECHNIEK
POSTBUS 1541
6201 BH MAASTRICHT
043-6190390

Client: LB METREX B.V.
Project: WARME STRAAT
Title: HOOK-UP
SEAC INTERFACE X915 BLAD 3
Tag number: SEAC9

Drawn by:	Filenumber:	Scale:	Size:	Ordernumber:	Sub.:	Drawing number:	Sht.:	of:	Rev.
M.V. 13-09-1994	SEAC9153	- : -	A4	9580	00	3-H-100	0000	0000	B

mm 0 10 20 30 40 50 60 70 80 90 100

Demo Version