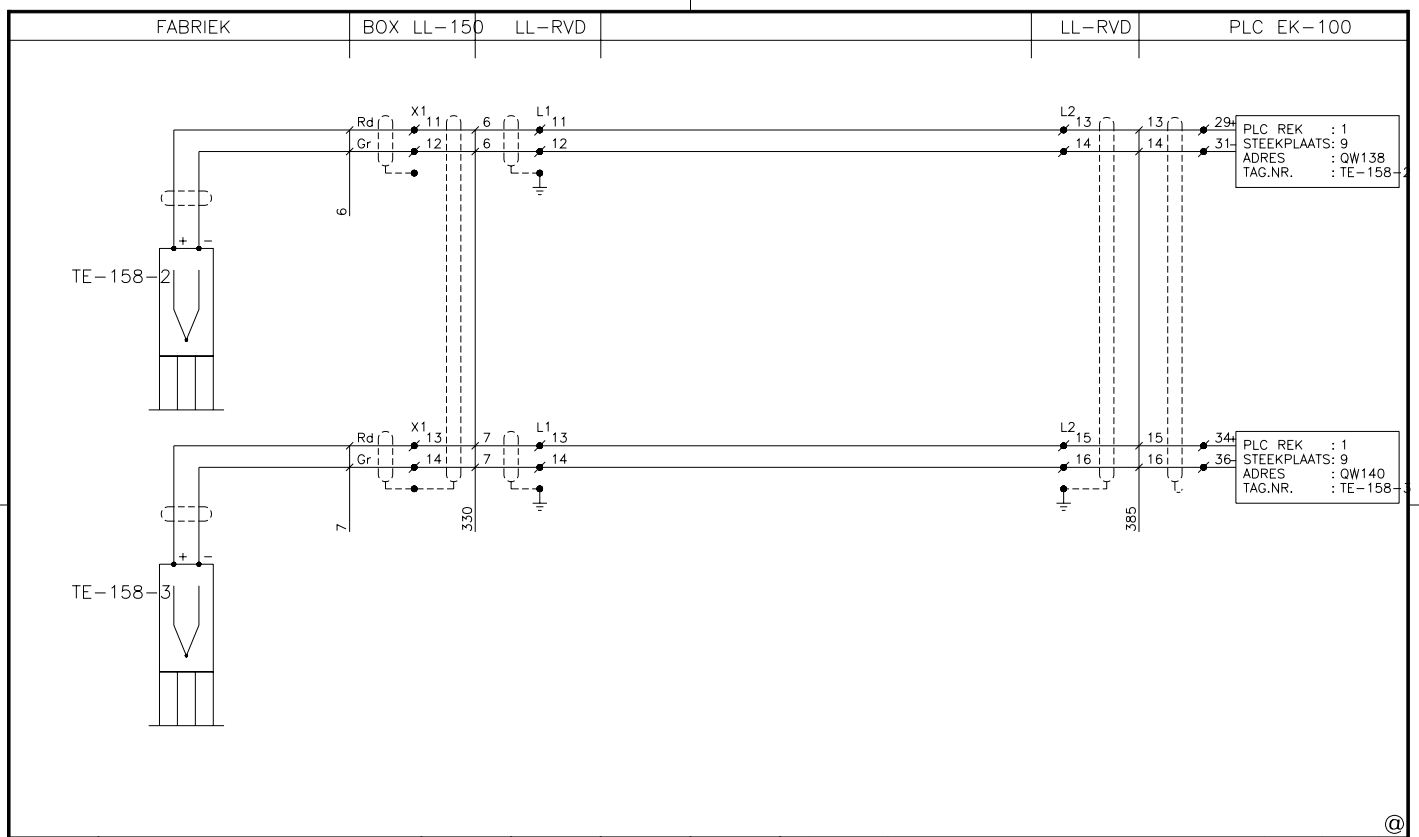

TE-158-3	SENSYCON TM110F 0-50mV	67			
TE-158-2	SENSYCON TM110F 0-50mV	67			
TAG Nr.:	Fabrikaat en Type:	Spec./Magn.Nr.	Instelling	Meetbereik	Opm./Tek.

Rev.:	Date:	Disription:	Drawn by:	Ckd:	Seen by:
A	15-12-1994	AS BUILT	R.B.	J.S.	J.Li
0	15-07-1994	FOR APPROVAL	R.G.	J.S.	J.Li

HVL ELEKTROTECHNIEK
POSTBUS 1541
6201 BH MAASTRICHT
043-6190190

Client: LB METREX B.V.
Project: WARME STRAAT
Title: HOOK-UP TEMPERATUUR BED 1
Tag number: T158-1

Drawn by:	Filenumber:	Scale:	Size:	Ordernumber:	Sub.:	Drawing number:	Sht.:	of:	Rev.
R.G. 05-07-1994	9158-1	- : -	A3	9580	00	T158-1	00	00	A

mm 0 10 20 30 40 50 60 70 80 90 100

Demo Version