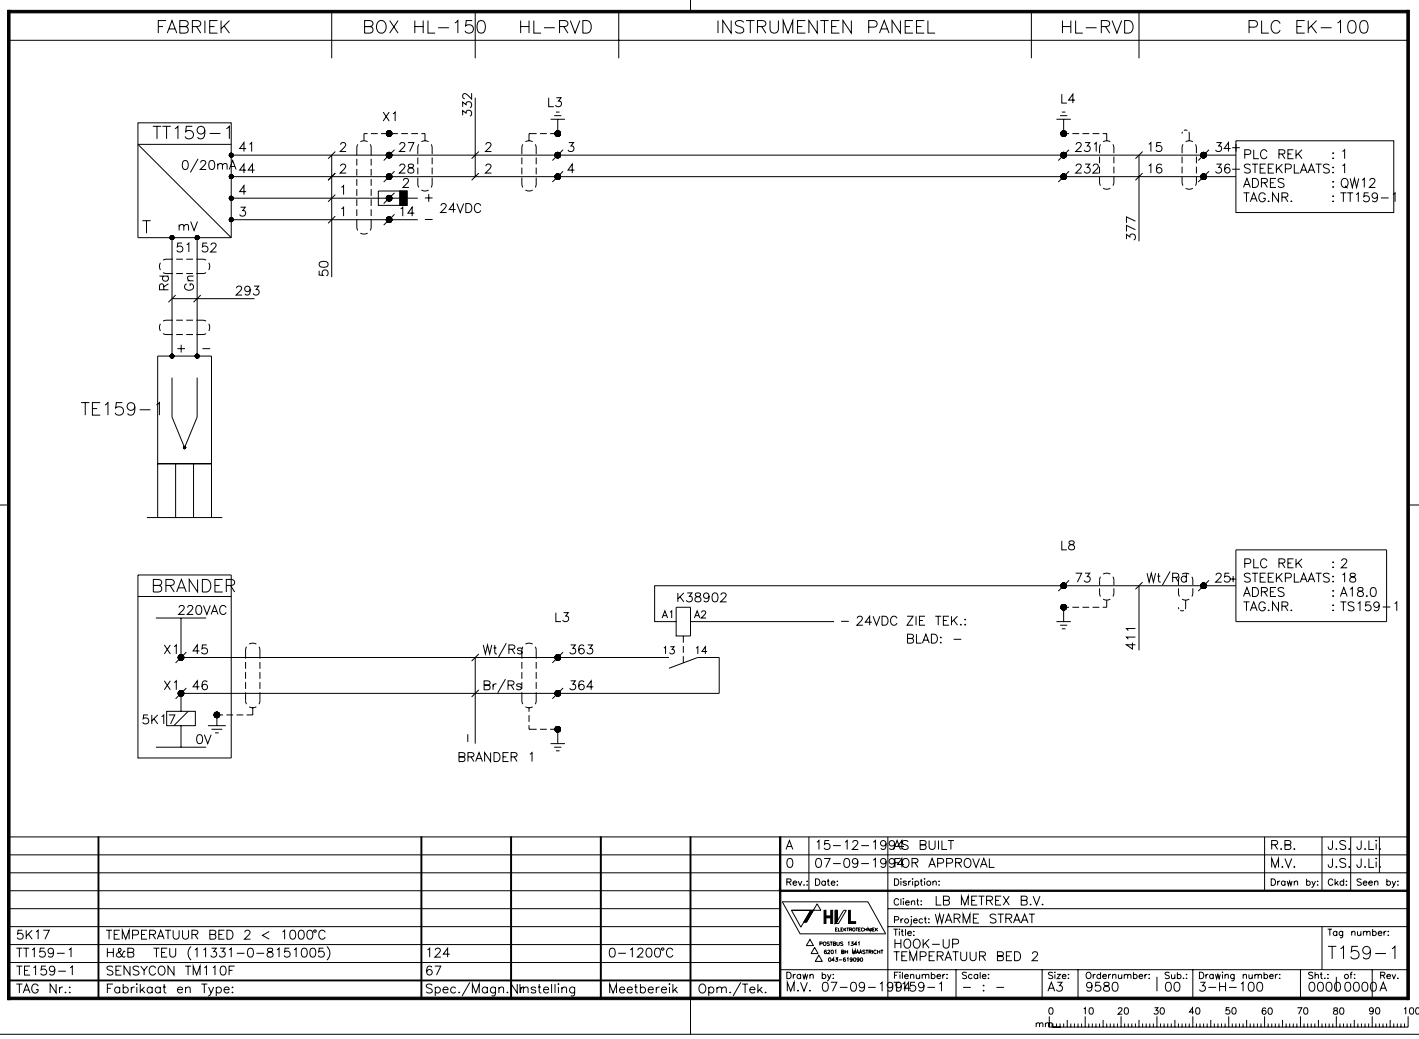

5K17	TEMPERATUUR BED 2 < 1000°C				
TT159-1	H&B TEU (11331-0-8151005)	124		0-1200°C	
TE159-1	SENSYCON TM110F	67			
TAG Nr.:	Fabrikaat en Type:	Spec./Magn.	Nmstelling	Meetbereik	Opm./Tek.

Rev.:	Date:	Disription:	Drawn by:	Ckd:	Seen by:
A	15-12-1994	AS BUILT	R.B.	J.S.	J.Li
0	07-09-1994	FOR APPROVAL	M.V.	J.S.	J.Li

HVL ELEKTROTECHNIEK
POSTBUS 1341
6201 BH MAASTRICHT
043-6190390

Client: LB METREX B.V.
Project: WARME STRAAT
Title: HOOK-UP TEMPERATUUR BED 2
Tag number: T159-1

Drawn by:	Filenumber:	Scale:	Size:	Ordernumber:	Sub.:	Drawing number:	Sht.:	of:	Rev.
M.V. 07-09-1994	TT159-1	- : -	A3	9580	00	3-H-100	00000	00000	A

Demo Version