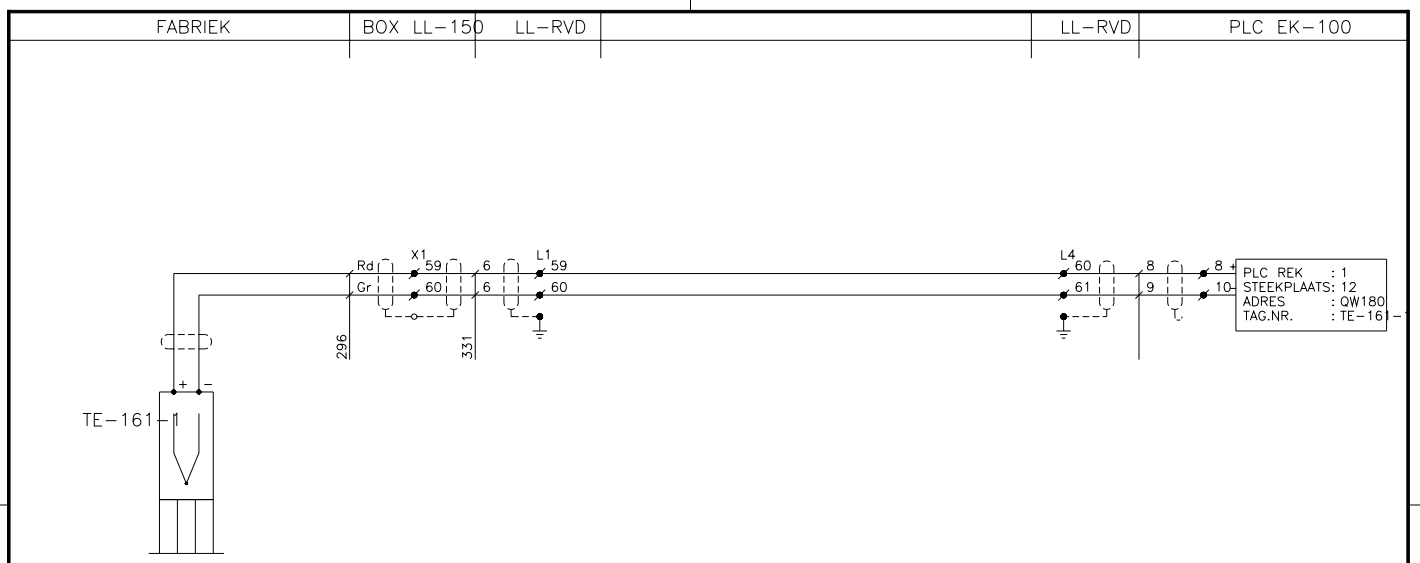


| Rev.: | Date: | Disription: | Drawn by: | Ckd: | Seen by: |
|---|---|---|---|---|---|
| A | 15-12-1994 | AS BUILT | R.B. | J.S. | J.Li |
| 0 | 07-09-1994 | FOR APPROVAL | M.V. | J.S. | J.Li |

HVL ELEKTROTECHNIEK
POSTBUS 1341
6201 BH MAASTRICHT
043-6190190

Client: LB METREX B.V.
Project: WARME STRAAT
Title: HOOK-UP TEMPERATUUR BED II
Tag number: T161-1

| Drawn by: | Filenumber: | Scale: | Size: | Ordernumber: | Sub.: | Drawing number: | Sht.: | of: | Rev. |
|---|---|---|---|---|---|---|---|---|---|
| M.V. 07-09-1994 | 9161-1 | - : - | A3 | 9580 | 00 | 3-H-100 | 00000 | 00000 | A |

| TAG Nr.: | Fabrikaat en Type: | Spec./Magn. | Nmstelling | Meetbereik | Opm./Tek. |
|---|---|---|---|---|---|
| TE-161-1 | SENSYCON TM110F | | | | |

0 10 20 30 40 50 60 70 80 90 100 mm

Demo Version