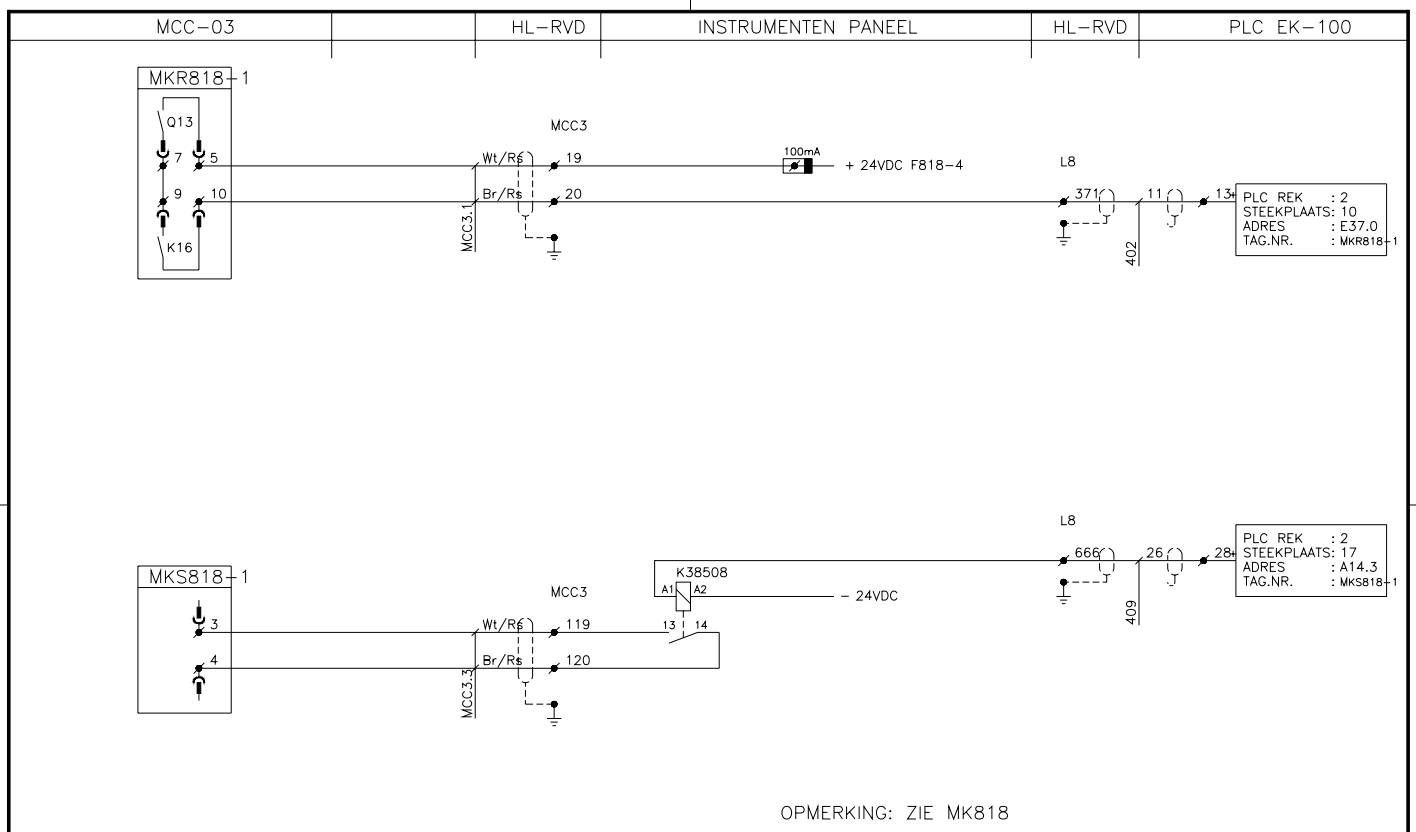

OPMERKING: ZIE MK818

Rev.:	Date:	Disription:	Drawn by:	Ckd:	Seen by:
C	07-12-1994	AS BUILT	N.S.	J.S.	J.Li
B	03-11-1993	SEVERAL CHANGES	R.G.	J.S.	J.Li

MKR818-1	RUN/STORING
MKS818-1	START/STOP

TAG Nr.:	Fabrikaat en Type:	Spec./Magn.	Nmstelling	Meetbereik	Opm./Tek.

HVL ELEKTROTECHNIEK
POSTBUS 1541
6201 BH MAASTRICHT
043-6190390

Client: LB METREX B.V.
Project: ROOKGAS ONTZWAVELING
Title: FLUEGAS VENTILATOR MK-818
RUN/STORING START/STOP
Tag number: MK818-1

Drawn by:	Filenumber:	Scale:	Size:	Ordernumber:	Sub.:	Drawing number:	Sht.:	of:	Rev.
M.V. 01-09-1994	MK818-1	- : -	A3	9580	00	3-H-800	0000	0000	C

mm 0 10 20 30 40 50 60 70 80 90 100

Demo Version