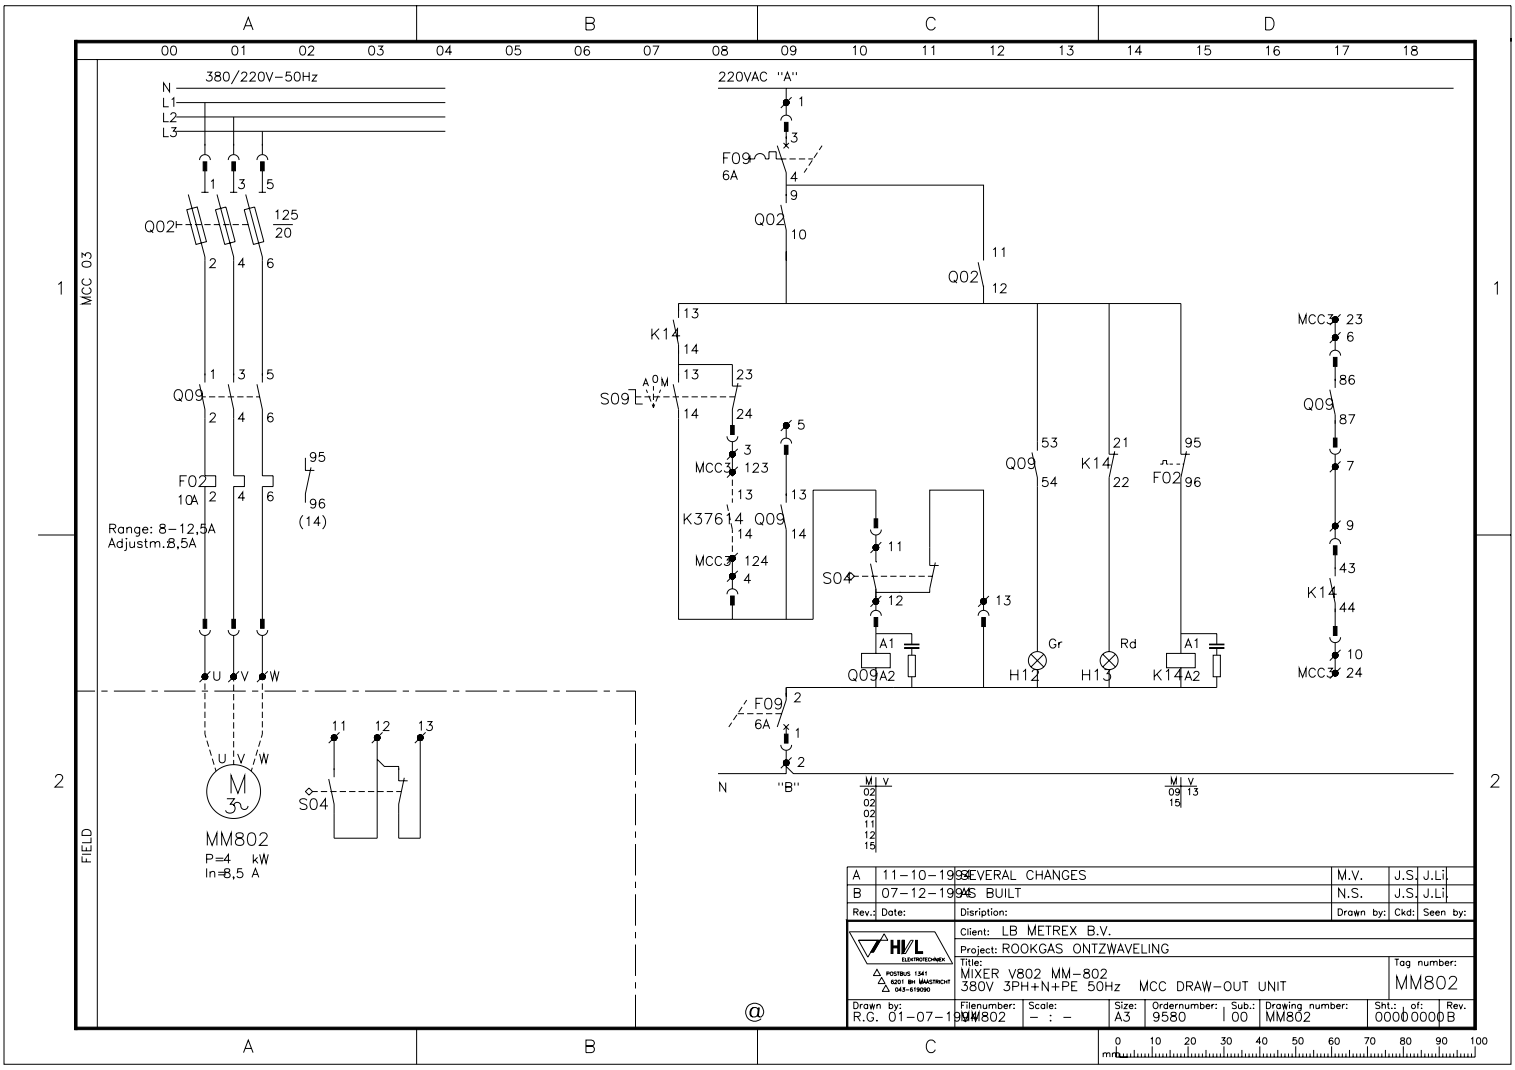

Rev.:	Date:	Disription:	Drawn by:	Ckd:	Seen by:
A	11-10-1993	SEVERAL CHANGES	M.V.	J.S.	J.Li
B	07-12-1994	AS BUILT	N.S.	J.S.	J.Li

HVL ELEKTROTECHNIEK
POSTBUS 1541
6201 BH MAASTRICHT
043-6116090

Client: LB METREX B.V.
Project: ROOKGAS ONTZWAVELING
Title: MIXER V802 MM-802
380V 3PH+N+PE 50Hz MCC DRAW-OUT UNIT
Tag number: MM802

Drawn by:	Filenumber:	Scale:	Size:	Ordernumber:	Sub.:	Drawing number:	Sht.:	of:	Rev.
R.G. 01-07-1994	MM802	- : -	A3	9580	00	MM802	00000	00000	B

Demo Version