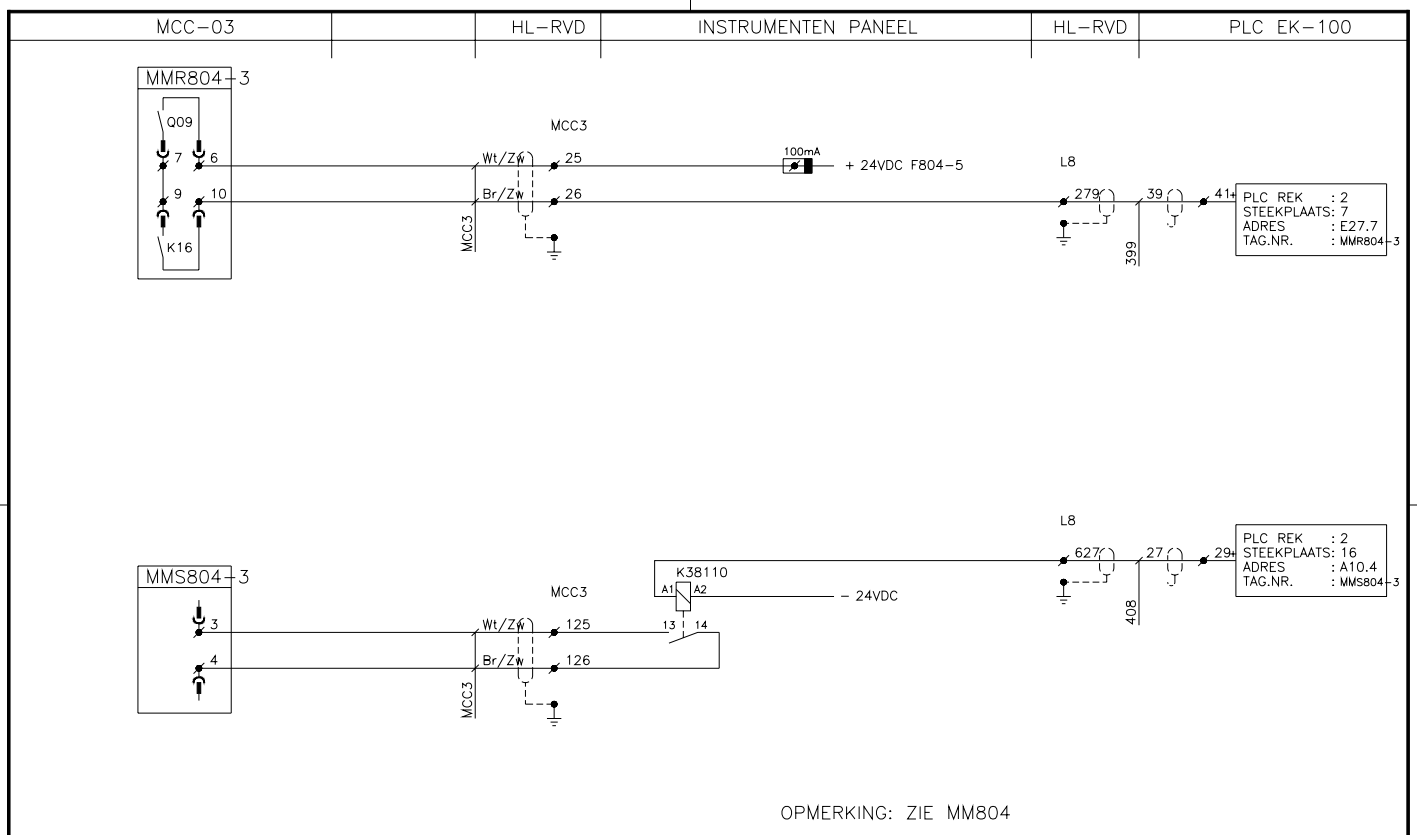


| Rev.: | Date: | Disription: | Drawn by: | Ckd: | Seen by: |
|---|---|---|---|---|---|
| C | 07-12-1994 | AS BUILT | N.S. | J.S. | J.Li |
| B | 03-11-1993 | SEVERAL CHANGES | R.G. | J.S. | J.Li |

| | |
|---|---|
| MMR804-3 | RUN/STORING |
| MMS804-3 | START/STOP |

| TAG Nr.: | Fabrikaat en Type: | Spec./Magn. | Instelling | Meetbereik | Opm./Tek. |
|---|---|---|---|---|---|

HVL ELEKTROTECHNIEK
POSTBUS 1541
6201 BH MAASTRICHT
043-6190190

Client: LB METREX B.V.
Project: ROOKGAS ONTZWAVELING
Title: MIXER V804 MM804
RUN/STORING START/STOP
Tag number: MM804-3

| Drawn by: | Filenumber: | Scale: | Size: | Ordernumber: | Sub.: | Drawing number: | Sht.: | of: | Rev. |
|---|---|---|---|---|---|---|---|---|---|
| M.V. 01-09-1994 | MM804-3 | - : - | A3 | 9580 | 00 | 3-H-800 | 0000 | 0000 | C |

mm 0 10 20 30 40 50 60 70 80 90 100

Demo Version