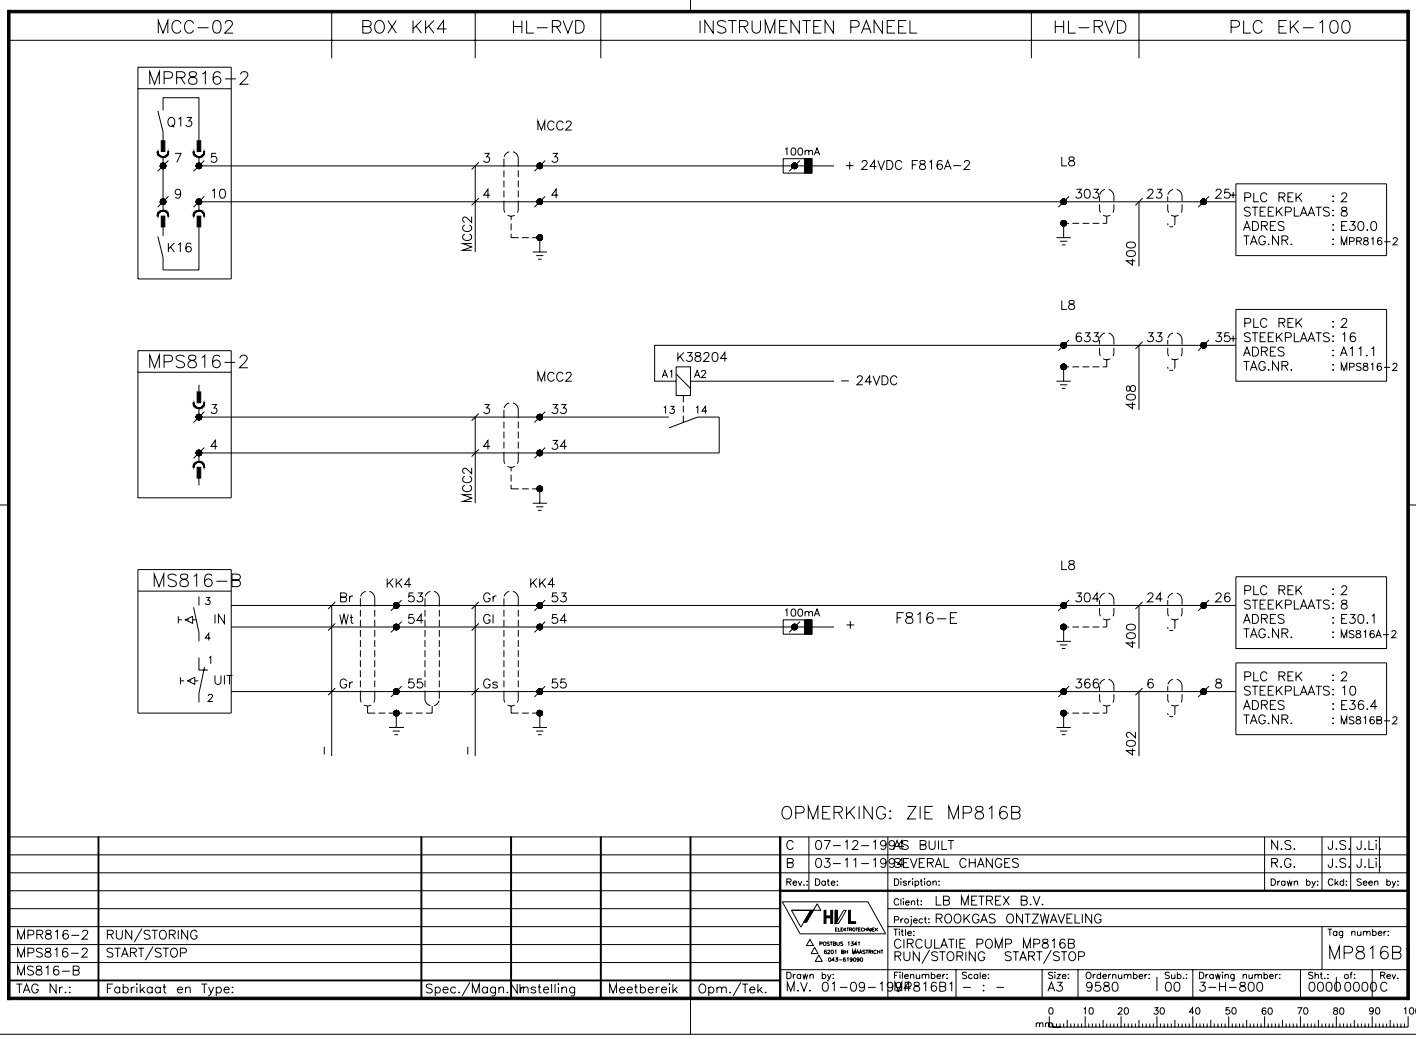

MPR816–2	RUN/STORING				
MPS816–2	START/STOP				
MS816–B					
TAG Nr.:	Fabrikaat en Type:	Spec./Magn.	Instelling	Meetbereik	Opm./Tek.

Rev.	Date:	Disription:	Drawn by:	Ckd:	Seen by:
C	07–12–1994	AS BUILT	N.S.	J.S.	J.Li
B	03–11–1993	SEVERAL CHANGES	R.G.	J.S.	J.Li

HVL ELEKTROTECHNIEK
POSTBUS 1341, 6201 BH MAASTRICHT, 043–618090

Client: LB METREX B.V.
Project: ROOKGAS ONTZWAVELING
Title: CIRCULATIE POMP MP816B
RUN/STORING START/STOP
Tag number: MP816B

Drawn by:	Filenumber:	Scale:	Size:	Ordernumber:	Sub.:	Drawing number:	Sht.:	of:	Rev.
M.V. 01–09–1993	MP816B1	– : –	A3	9580	00	3–H–800	00000	00000	C

mm 0 10 20 30 40 50 60 70 80 90 100

Demo Version