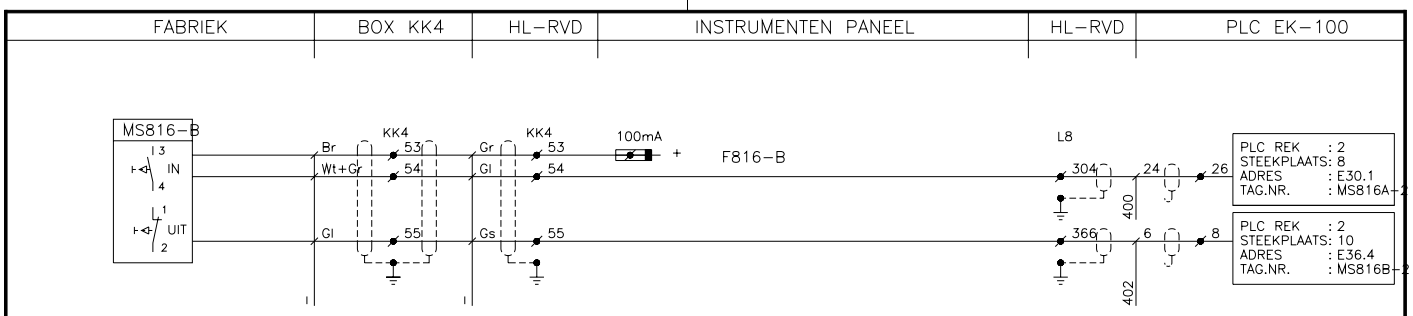

Rev.:	Date:	Disription:	Drawn by:	Ckd:	Seen by:
A	26-10-1993	SEVERAL CHANGES	R.G.	J.S.	J.Li
B	14-12-1994	AS BUILT	N.S.	J.S.	J.Li

HVL ELEKTROTECHNIEK
POSTBUS 1341
6201 BH MAASTRICHT
043-6190190

Client: LB METREX B.V.
Project: ROOKGAS ONTZWAVELING
Title: HOOK-UP
START / STOP POMP P816B

Tag number: MS816-B

Drawn by:	Filenumber:	Scale:	Size:	Ordernumber:	Sub.:	Drawing number:	Sht.:	of:	Rev.
R.G. 25-08-1993	MS816-B	- : -	A3	9580	00	3-H-800	0000	0000	B

TAG Nr.:	Fabrikaat en Type:	Spec./Magn.	Instelling	Meetbereik	Opm./Tek.
MS816B					

mm 0 10 20 30 40 50 60 70 80 90 100

Demo Version