P607A(MCC)	HL-RVD	HL-RVD	PLC EK-100

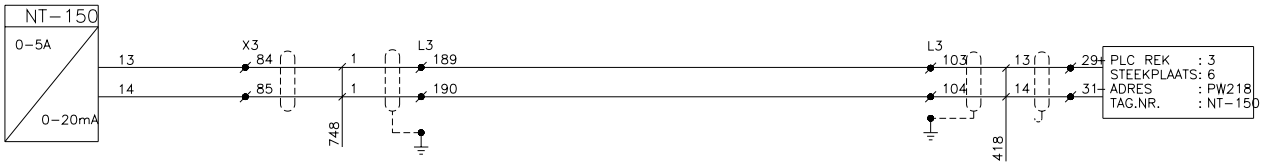

ZIE VERDER TEK. 3-E-106
BLAD 6 KRING 06

Rev.:	Date:	Disription:	Drawn by:	Ckd:	Seen by:
A	31-12-1994	AS BUILT	N.S.	J.S.	J.Li

HVL ELEKTROTECHNIEK
POSTBUS 1341
6201 BH MAASTRICHT
043-6190190

Client: LB METREX B.V.
Project: ROOKGAS ONTZWAVELING
Title: VERMOGENMETING VERBRANDINGSLUCHTVENT.(MK150)
Tag number: N-150

Drawn by:	Filenumber:	Scale:	Size:	Ordernumber:	Sub.:	Drawing number:	Sht.:	of:	Rev.
N.S. 13-12-1994	N-150	- : -	A3	9580	00	3-H-100	00000	00000	A

NT-150	BBC GTU 153				
TAG Nr.:	Fabrikaat en Type:	Spec./Magn.	Instelling	Meetbereik	Opm./Tek.

mm 0 10 20 30 40 50 60 70 80 90 100

Demo Version