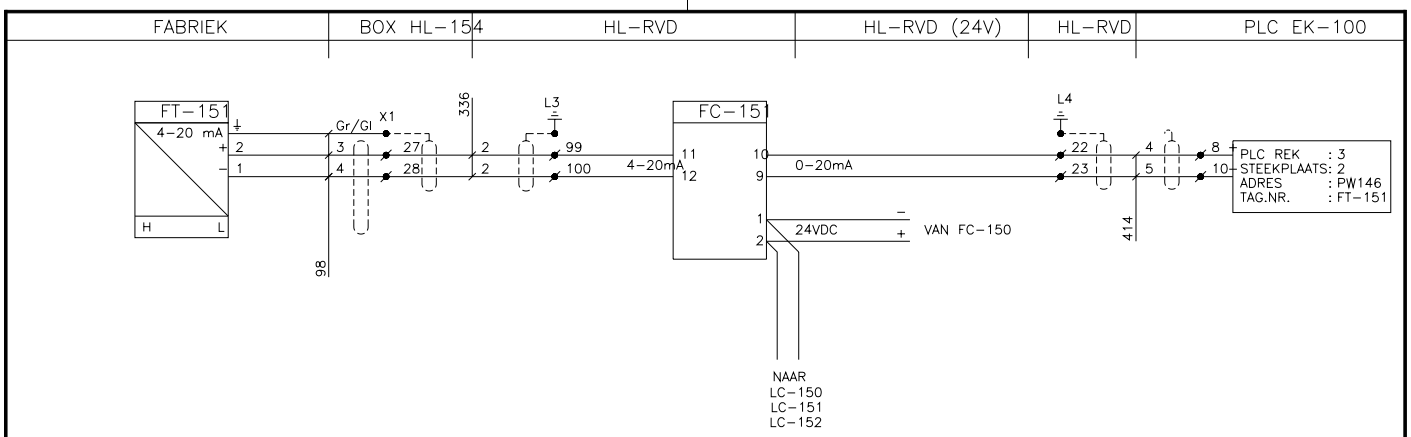

FC-151	ATM NC 22-028-020				
FT-151	ROSEMOUNT SMART 1151		0-500 mBAR	0-600 mBAR	
TAG Nr.:	Fabrikaat en Type:	Spec./Magn.Nr.	Instelling	Meetbereik	Opm./Tek.

Rev.:	Date:	Disription:	Drawn by:	Ckd:	Seen by:
A	14-12-1994	AS BUILT	R.B.	J.S.	J.Li
0					

HVL ELEKTROTECHNIEK
POSTBUS 1341
6201 BH MAASTRICHT
043-618090

Client: LB METREX B.V.
Project: WARME STRAAT
Title: HOOK-UP STOOMSTROOM NAAR BUFFERVAT V-151
Tag number: F-151

Drawn by:	Filenumber:	Scale:	Size:	Ordernumber:	Sub.:	Drawing number:	Sht.:	of:	Rev.
R.B. 14-12-1994	4151	- : -	A3	9580	00	3-H-100	00000001		A

0 10 20 30 40 50 60 70 80 90 100 mm

Demo Version