FABRIEK	BOX KK3	HL–RVD	INSTRUMENTEN PANEEL	HL–RVD	PLC EK–100

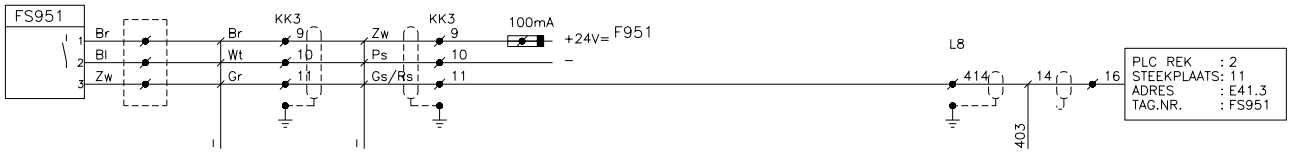

						A	25–10–1994	SEVERAL CHANGES	R.G.	J.S.	J.Li
						B	14–12–1994	AS BUILT	N.S.	J.S.	J.Li
						Rev.:	Date:	Disription:	Drawn by:	Ckd:	Seen by:
						Client: LB METREX B.V.					
						Project: ROOKGAS ONTZWAVELING					
						Title: HOOK–UP MINIMALE FLOW P950				Tag number: F–951	
FS 951	WEBER/CAPTOR 4120.13					Drawn by: M.V. 29–08–1994	Filenumber: 4951	Scale: – : –	Size: A3	Ordernumber: 9580	Sub.: 00	Drawing number: 3–H–900	Sht.: 00 of: 00	Rev. B
TAG Nr.:	Fabrikaat en Type:	Spec./Magn.	Nmstelling	Meetbereik	Opm./Tek.						

Demo Version