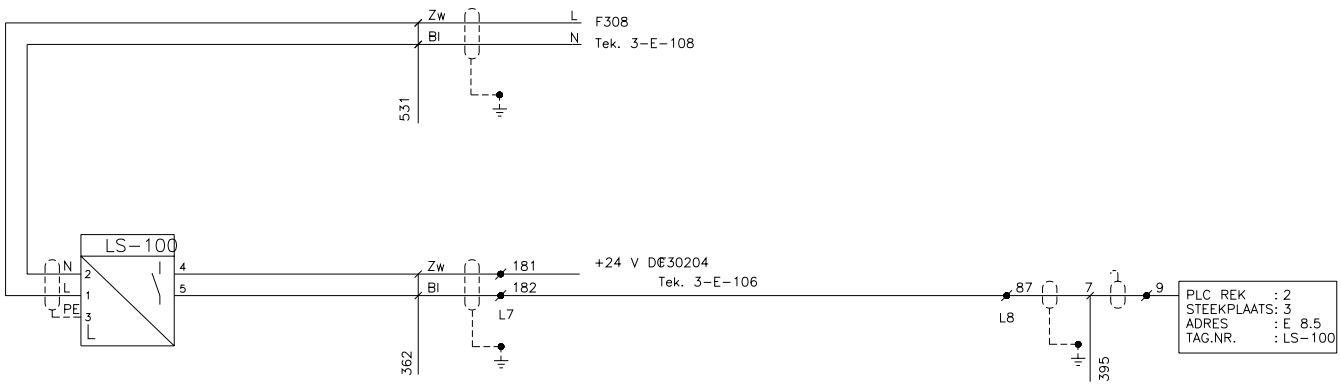


| Rev. | Date: | Disription: | Drawn by: | Ckd: | Seen by: |
|---|---|---|---|---|---|
| A | 06-09-1994 | FOR APPROVAL | M.V. | J.S. | J.Li |
| B | 13-12-1994 | AS BUILT | P.G. | J.S. | J.Li |

HVL ELEKTROTECHNIEK
POSTBUS 1341
6201 BH MAASTRICHT
043-618090

Client: LB METREX B.V.
Project: ROOKGAS ONTZWAVELING
Title: HOOK-UP
HOOG NIVEAU SCHAK. B-128
Tag number: L-100

| Drawn by: | Filenumber: | Scale: | Size: | Ordernumber: | Sub.: | Drawing number: | Sht.: | of: | Rev. |
|---|---|---|---|---|---|---|---|---|---|
| P.G. 13-12-1994 | 4100 | - : - | A4 | 9580 | 00 | 3-H-100 | 00000 | 00000 | B |

| TAG Nr.: | Fabrikaat en Type: | Spec./Magn.Instelling | Meetbereik | Opm./Tek. |
|---|---|---|---|---|
| LS-100 | E&H FTM-230 | | | |

0 10 20 30 40 50 60 70 80 90 100 mm

Demo Version