FABRIEK	KK-150	E-RVD		E-RVD	PLC EK-100

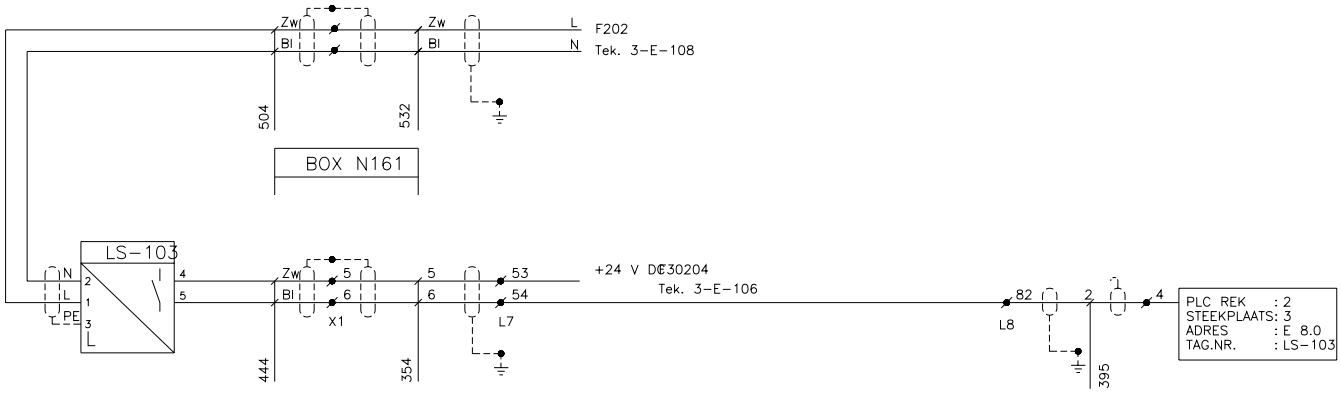

Rev.:	Date:	Disription:	Drawn by:	Ckd:	Seen by:
A	06-09-1994	FOR APPROVAL	M.V.	J.S.	J.Li
B	13-12-1994	AS BUILT	P.G.	J.S.	J.Li

HVL ELEKTROTECHNIEK
POSTBUS 1341
6201 BH MAASTRICHT
043-6116090

Client: LB METREX B.V.
Project: ROOKGAS ONTZWAVELING
Title: HOOK-UP
LAAG NIVEAU SCHAK. B-129
Tag number: L-103

Drawn by:	Filenumber:	Scale:	Size:	Ordernumber:	Sub.:	Drawing number:	Sht.:	of:	Rev.
P.G. 13-12-1994	94103	- : -	A4	9580	00	3-H-100	00000	00000	B

LS-103	E&H FTM-230				
TAG Nr.:	Fabrikaat en Type:	Spec./Magn.	Nmstelling	Meetbereik	Opm./Tek.

0 10 20 30 40 50 60 70 80 90 100 mm

Demo Version