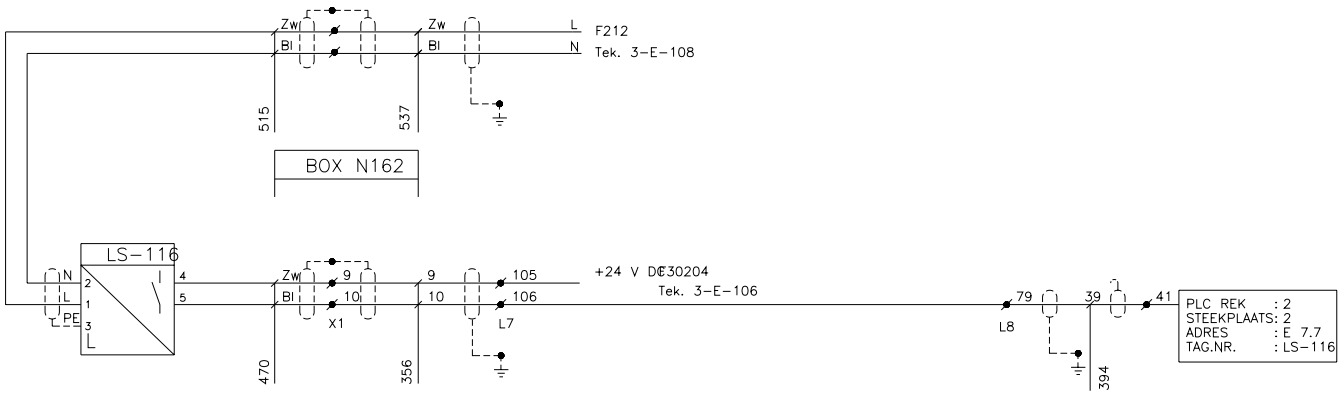

						A	06-09-1994	FOR APPROVAL	M.V.	J.S.	J.Li
						B	14-12-1994	AS BUILT	P.G.	J.S.	J.Li
						Rev.:	Date:	Disription:	Drawn by:	Ckd:	Seen by:
						Client: LB METREX B.V.					
						Project: ROOKGAS ONTZWAVELING					
						Title: HOOK-UP HOOG NIVEAU SCHAK. B-135				Tag number: L-116	
LS-116	E&H FTM-230					Drawn by: P.G. 14-12-1994	Filenumber: 94116	Scale: - : -	Size: A4	Ordernumber: 9580	Sub.: 00	Drawing number: 3-H-100	Sht.: 0000 of: 0000	Rev. B
TAG Nr.:	Fabrikaat en Type:	Spec./Magn.Instelling		Meetbereik	Opm./Tek.						

Demo Version