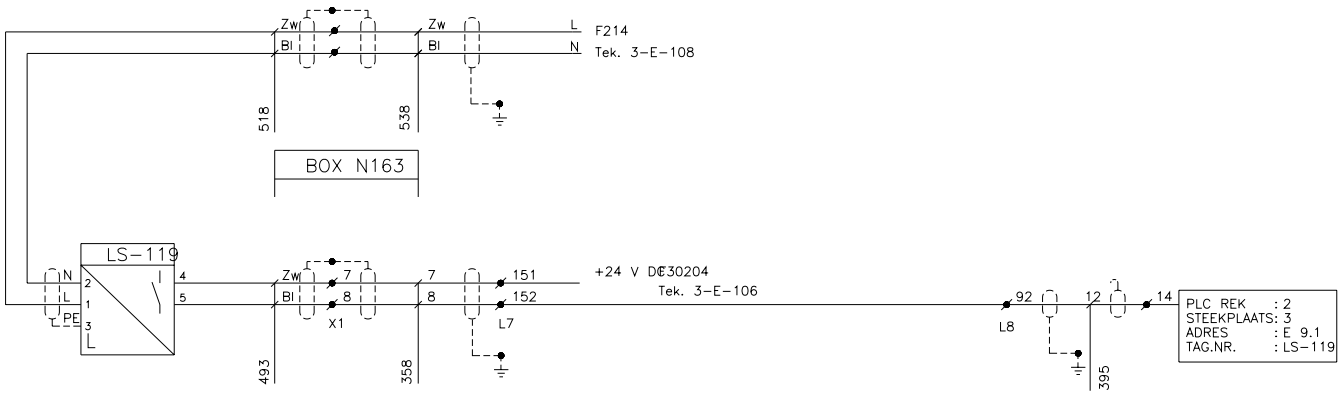

Rev.	Date:	Disription:	Drawn by:	Ckd:	Seen by:
A	06-09-1994	FOR APPROVAL	M.V.	J.S.	J.Li
B	14-12-1994	AS BUILT	P.G.	J.S.	J.Li

HVL ELEKTROTECHNIEK
POSTBUS 1341
6201 BH MAASTRICHT
043-618090

Client: LB METREX B.V.
Project: ROOKGAS ONTZWAVELING
Title: HOOK-UP
HOOG NIVEAU SCHAK. B-137
Tag number: L-119

Drawn by:	Filenumber:	Scale:	Size:	Ordernumber:	Sub.:	Drawing number:	Sht.:	of:	Rev.
P.G. 14-12-1994	4119	- : -	A4	9580	00	3-H-100	00000	0000	B

TAG Nr.:	Fabrikaat en Type:	Spec./Magn.Instelling	Meetbereik	Opm./Tek.
LS-119	E&H FTM-230			

mm 0 10 20 30 40 50 60 70 80 90 100

Demo Version